


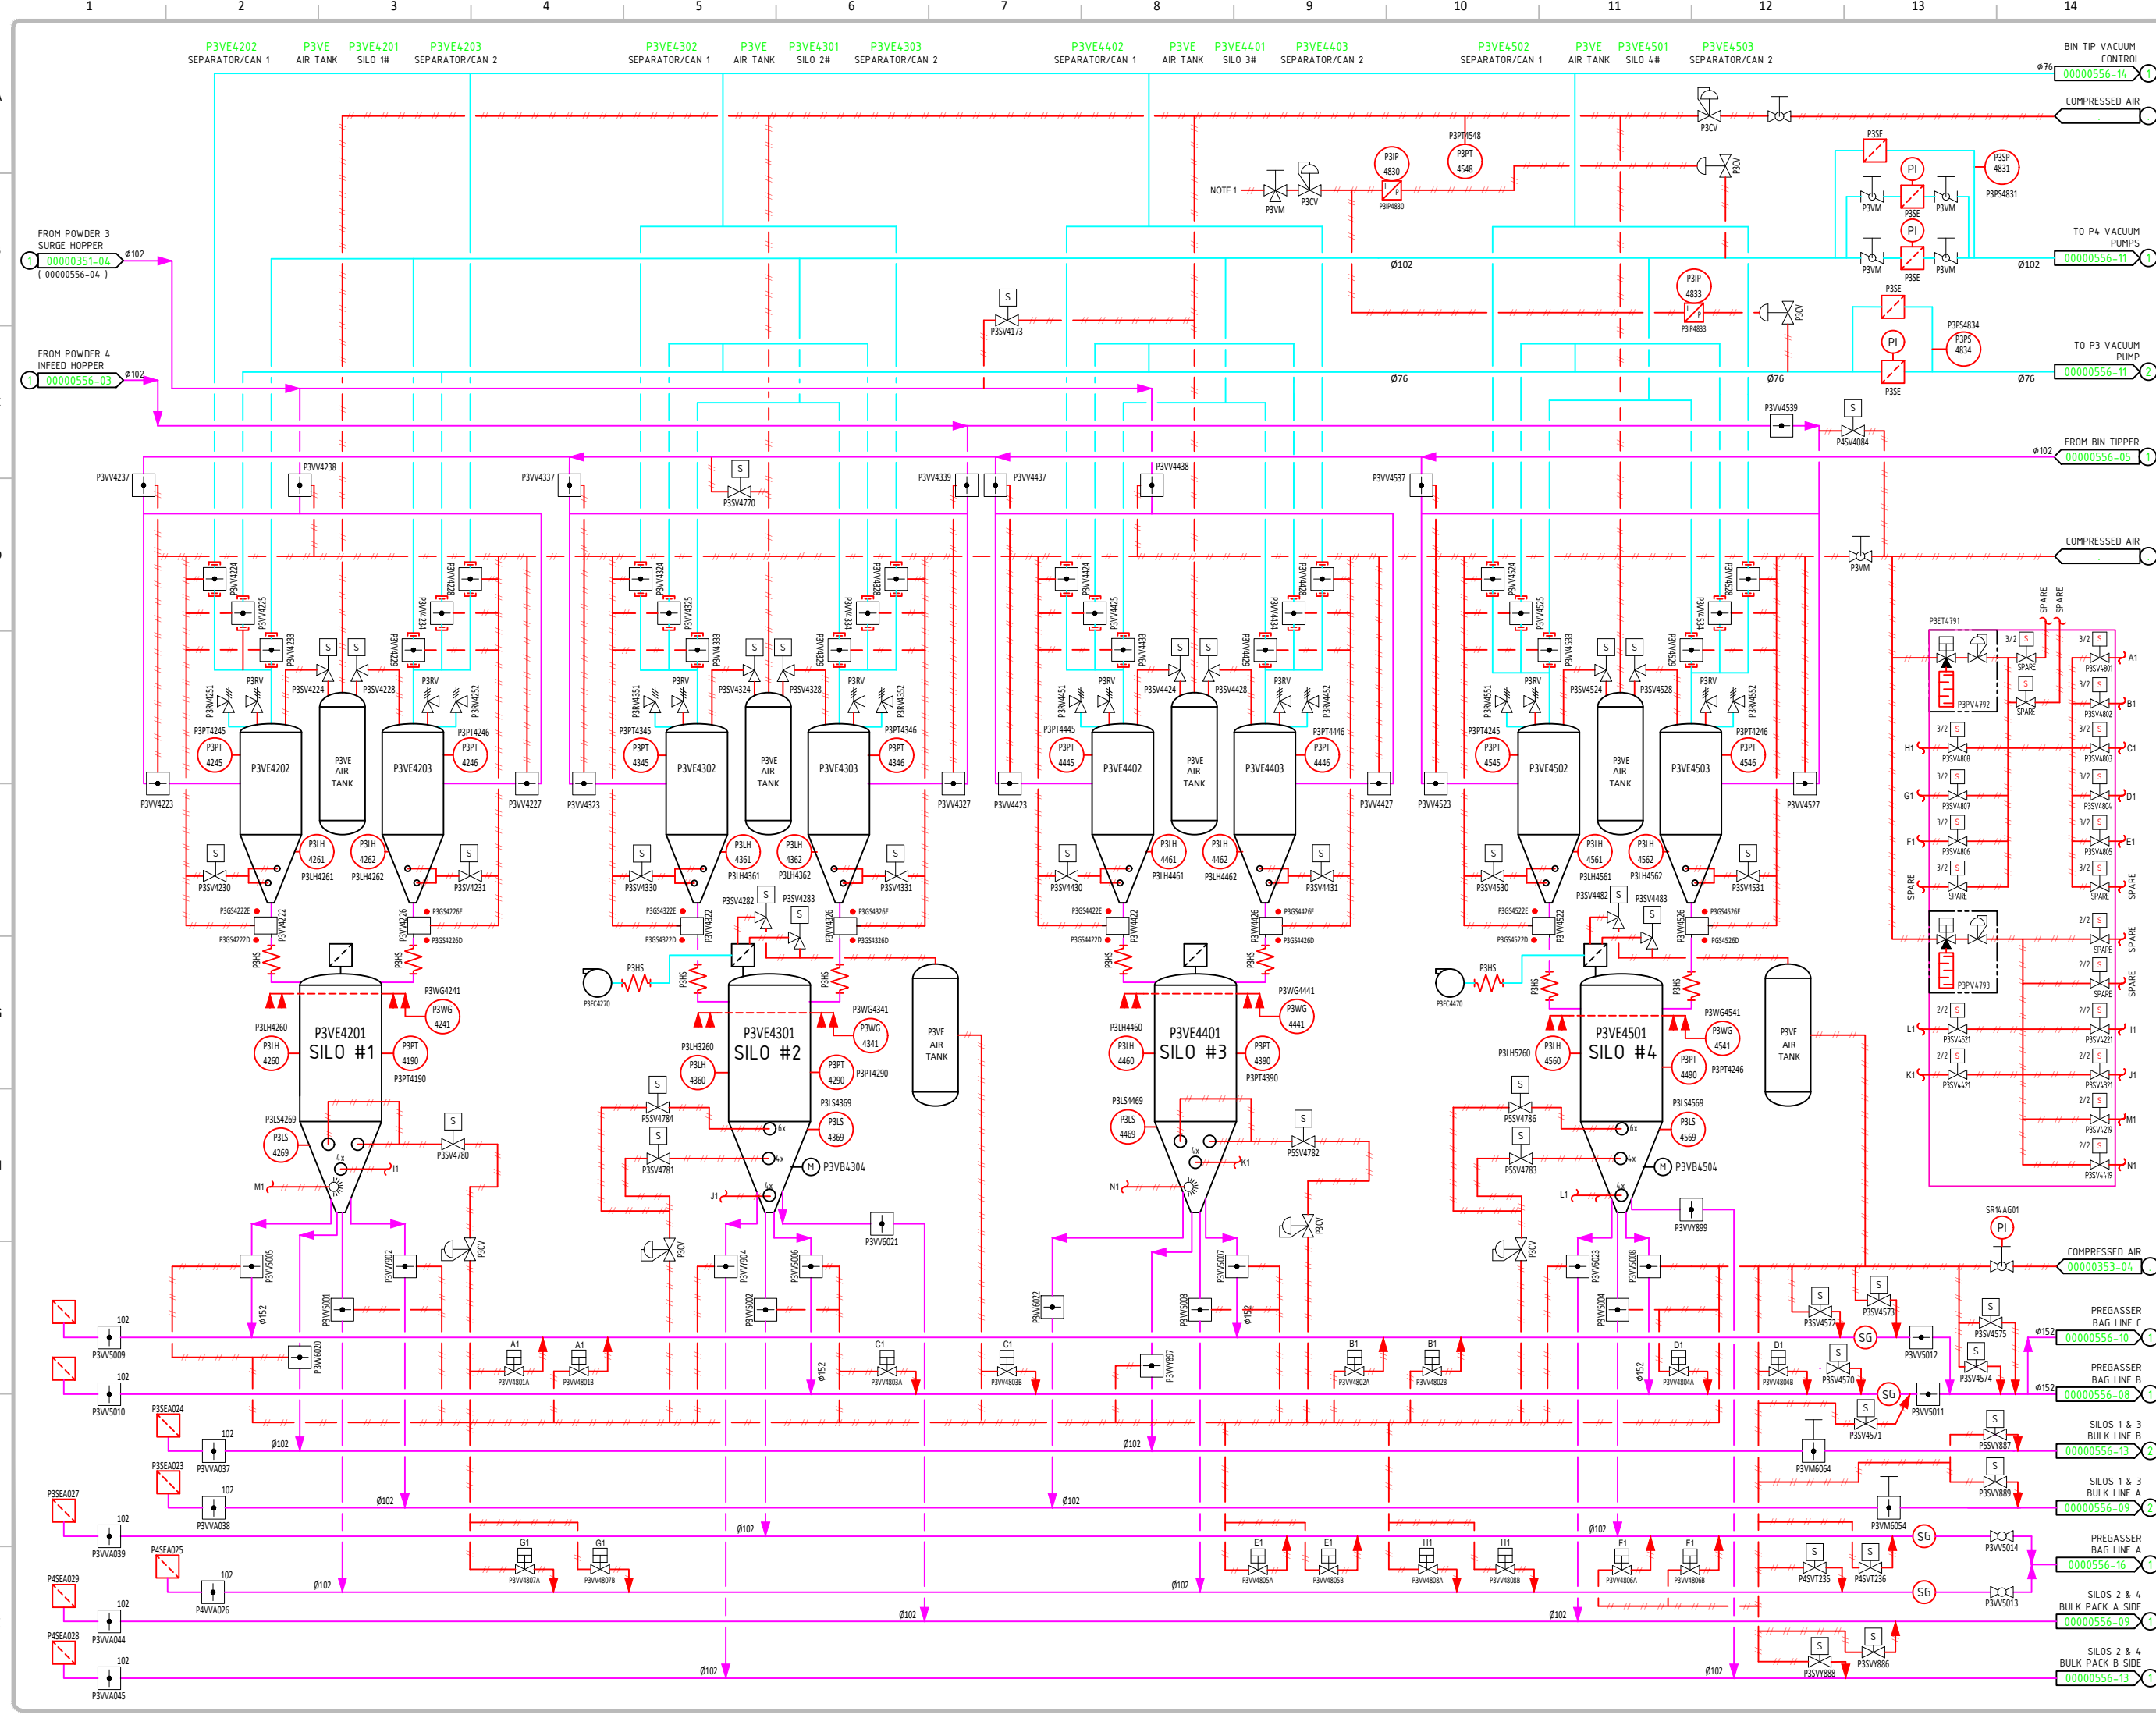

A1

NOTES:

1- Air line disconnected

COLBY

43699P07

REFERENCE DRAWINGS

00000353-04	P3 COMPRESSED AIR DISTRIBUTION P&ID
00000351-04	P3# SPRAY DRIER FLUIDBEDS & HEATERS P&ID
00000556-03	POWDER 4# INFEDD HOPPER P&ID
00000556-05	BIN TIPPER POWDER 5#
00000556-06	SILOS 5 & 6 & SEPARATORS POWDER 5#
00000556-08	PREGASSING SYSTEM B 25KG BAG LINE P3#
00000556-10	PREGASSING SYSTEM C 25KG BAG LINE P3#
00000556-11	VACUUM PUMPS POWDER 5#
00000556-13	BULK PACKER HOPPER B POWDER 5#
00000556-16	PREGASSING SYSTEM A 25KG BAG LINE P#
00000556-04	SURGE HOPPER POWDER 3#

REVISIONS

4	ISSUED - Mohamed Chaar@fetrapak.com	SAC	07.06.2024
L	AS BUILT - Mohamed Chaar@fetrapak.com	SAC	10.04.2024
3	ISSUED - Henri Viljoen@fetrapak.com	SAC	21.11.2023
K	AS BUILT - Mohamed Chaar@fetrapak.com	SAC	14.11.2023
2	ISSUED - Mohamed Chaar@fetrapak.com	SAC	23.08.2023
J	AS BUILT - TRANSPORT LINES PROJECT	MCH	20.06.2022
I	FORMAT UPDATE	SAC	24.11.2021
H	CONTINUATIONS & BLOCKS	HPM	02.06.2016

DO NOT SCALE
REPORT ALL ERRORS

Copyright notice

Drawn: COLBY
Checked: COLBY

Date: 09.01.1997
Scale: NTS

Title: WHAREROA POWDER 3
SILOS 1, 2, 3 & 4
& SEPARATORS
P&ID

Dwg No. 00000556-07
SITE WH PLANT PS DISCIPLINE PI TYPE S

Rev 4