


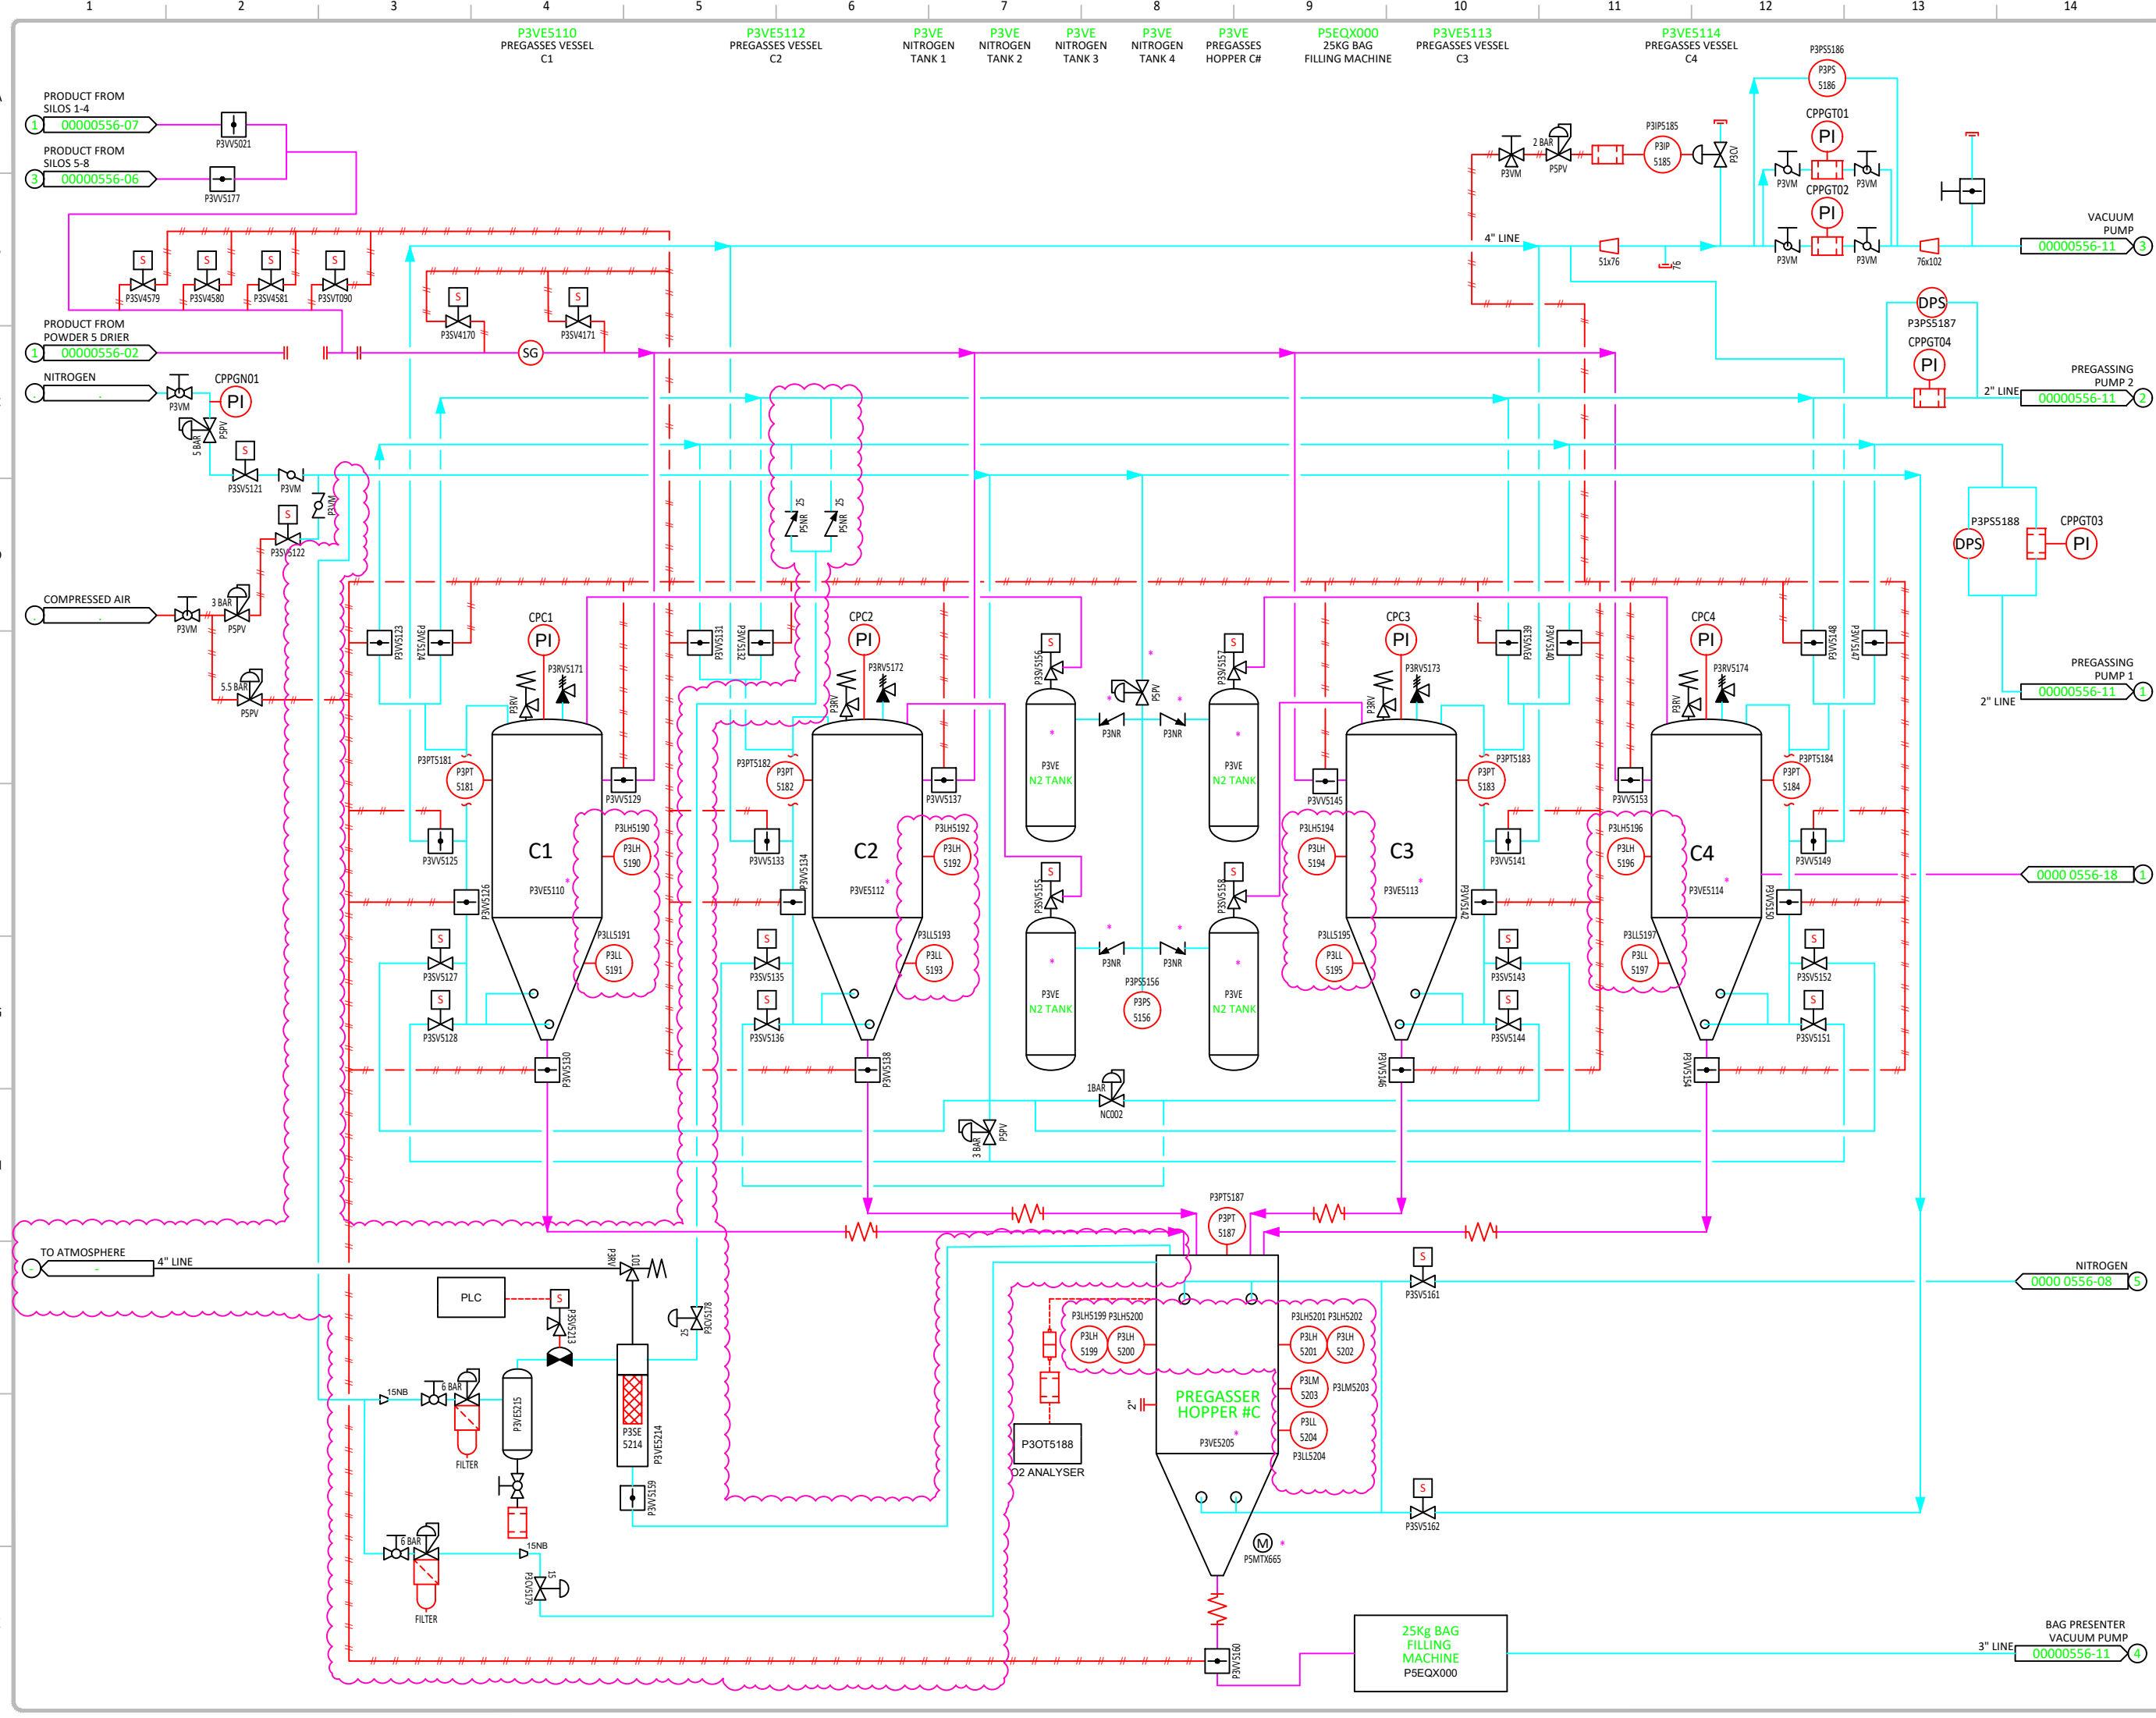

A1

NOTES:

* METAL MAPPING POTENTIAL CONTAMINATION POINT.

COLBY

DWG - 43699P10

REFERENCE DRAWINGS			
	FONTERRA PIPING/MECHANICAL LEGEND SHEETS		
	FONTERRA P&ID LEGEND SHEETS		
00000556-02	POWDER 5 INFED HOPPER P&ID		
00000556-04	POWDER 3 SURGE HOPPER P&ID		
00000556-06	POWDER 5 SILOS 5 & 6 & SEPARATORS P&ID		
00000556-07	POWDER 5 SILOS 1-4 & SEPARATORS P&ID		
00000556-11	POWDER 5 VACUUM PUMPS P&ID		
	COMPRESSED AIR SUPPLY		
	NITROGEN SUPPLY		
	(FUTURE DWG) 25KG BAGGING MACHINE P&ID		

REVISIONS			
6	AS BUILT - ben.walkey@tetrapak.com	RFI	25.07.2025
H	UPDATE - BRENDON FISCHER	SAC	23.09.2021
5	ISSUED - Reed.Fisher@tetrapak.com	SAC	17.03.2025
K	AS BUILT - TETRA PAK	SAC	17.12.2024
4	ISSUED - Mohamed.Chaar@tetrapak.com	SAC	10.06.2024
3	AS BUILT - Mohamed.Chaar@tetrapak.com	MC	10.04.2024
2	ISSUED - Henri.Viljoen@tetrapak.com	SAC	21.11.2023
J	FORMAT UPDATE	SAC	28.10.2022
1	AS BUILT - TRANSPORT LINES PROJECT	MCH	20.06.2022

DO NOT SCALE

REPORT ALL ERRORS

Fonterra_rgh_std_L.PNG

Tetra Pak

PROTECTS WHAT'S GOOD

COPYRIGHT:

THIS DRAWING IS THE EXCLUSIVE PROPERTY OF FONTERRA. IT MUST NOT BE COPIED BY ANY MEANS, WITHOUT THE WRITTEN CONSENT OF FONTERRA DRAWING CONTROL.

Drawn

COLBY

Date

07.01.1996

Checked

COLBY

Scale

NTS

Title:

WHAREROA POWDER 3
25KG BAG LINE "C"
PREGASSING SYSTEM C
P&ID

Dwg No.	00000556 - 10	Rev	6
SITE	WH	PLANT	P5
DISCIPLINE	PI	TYPE	S