


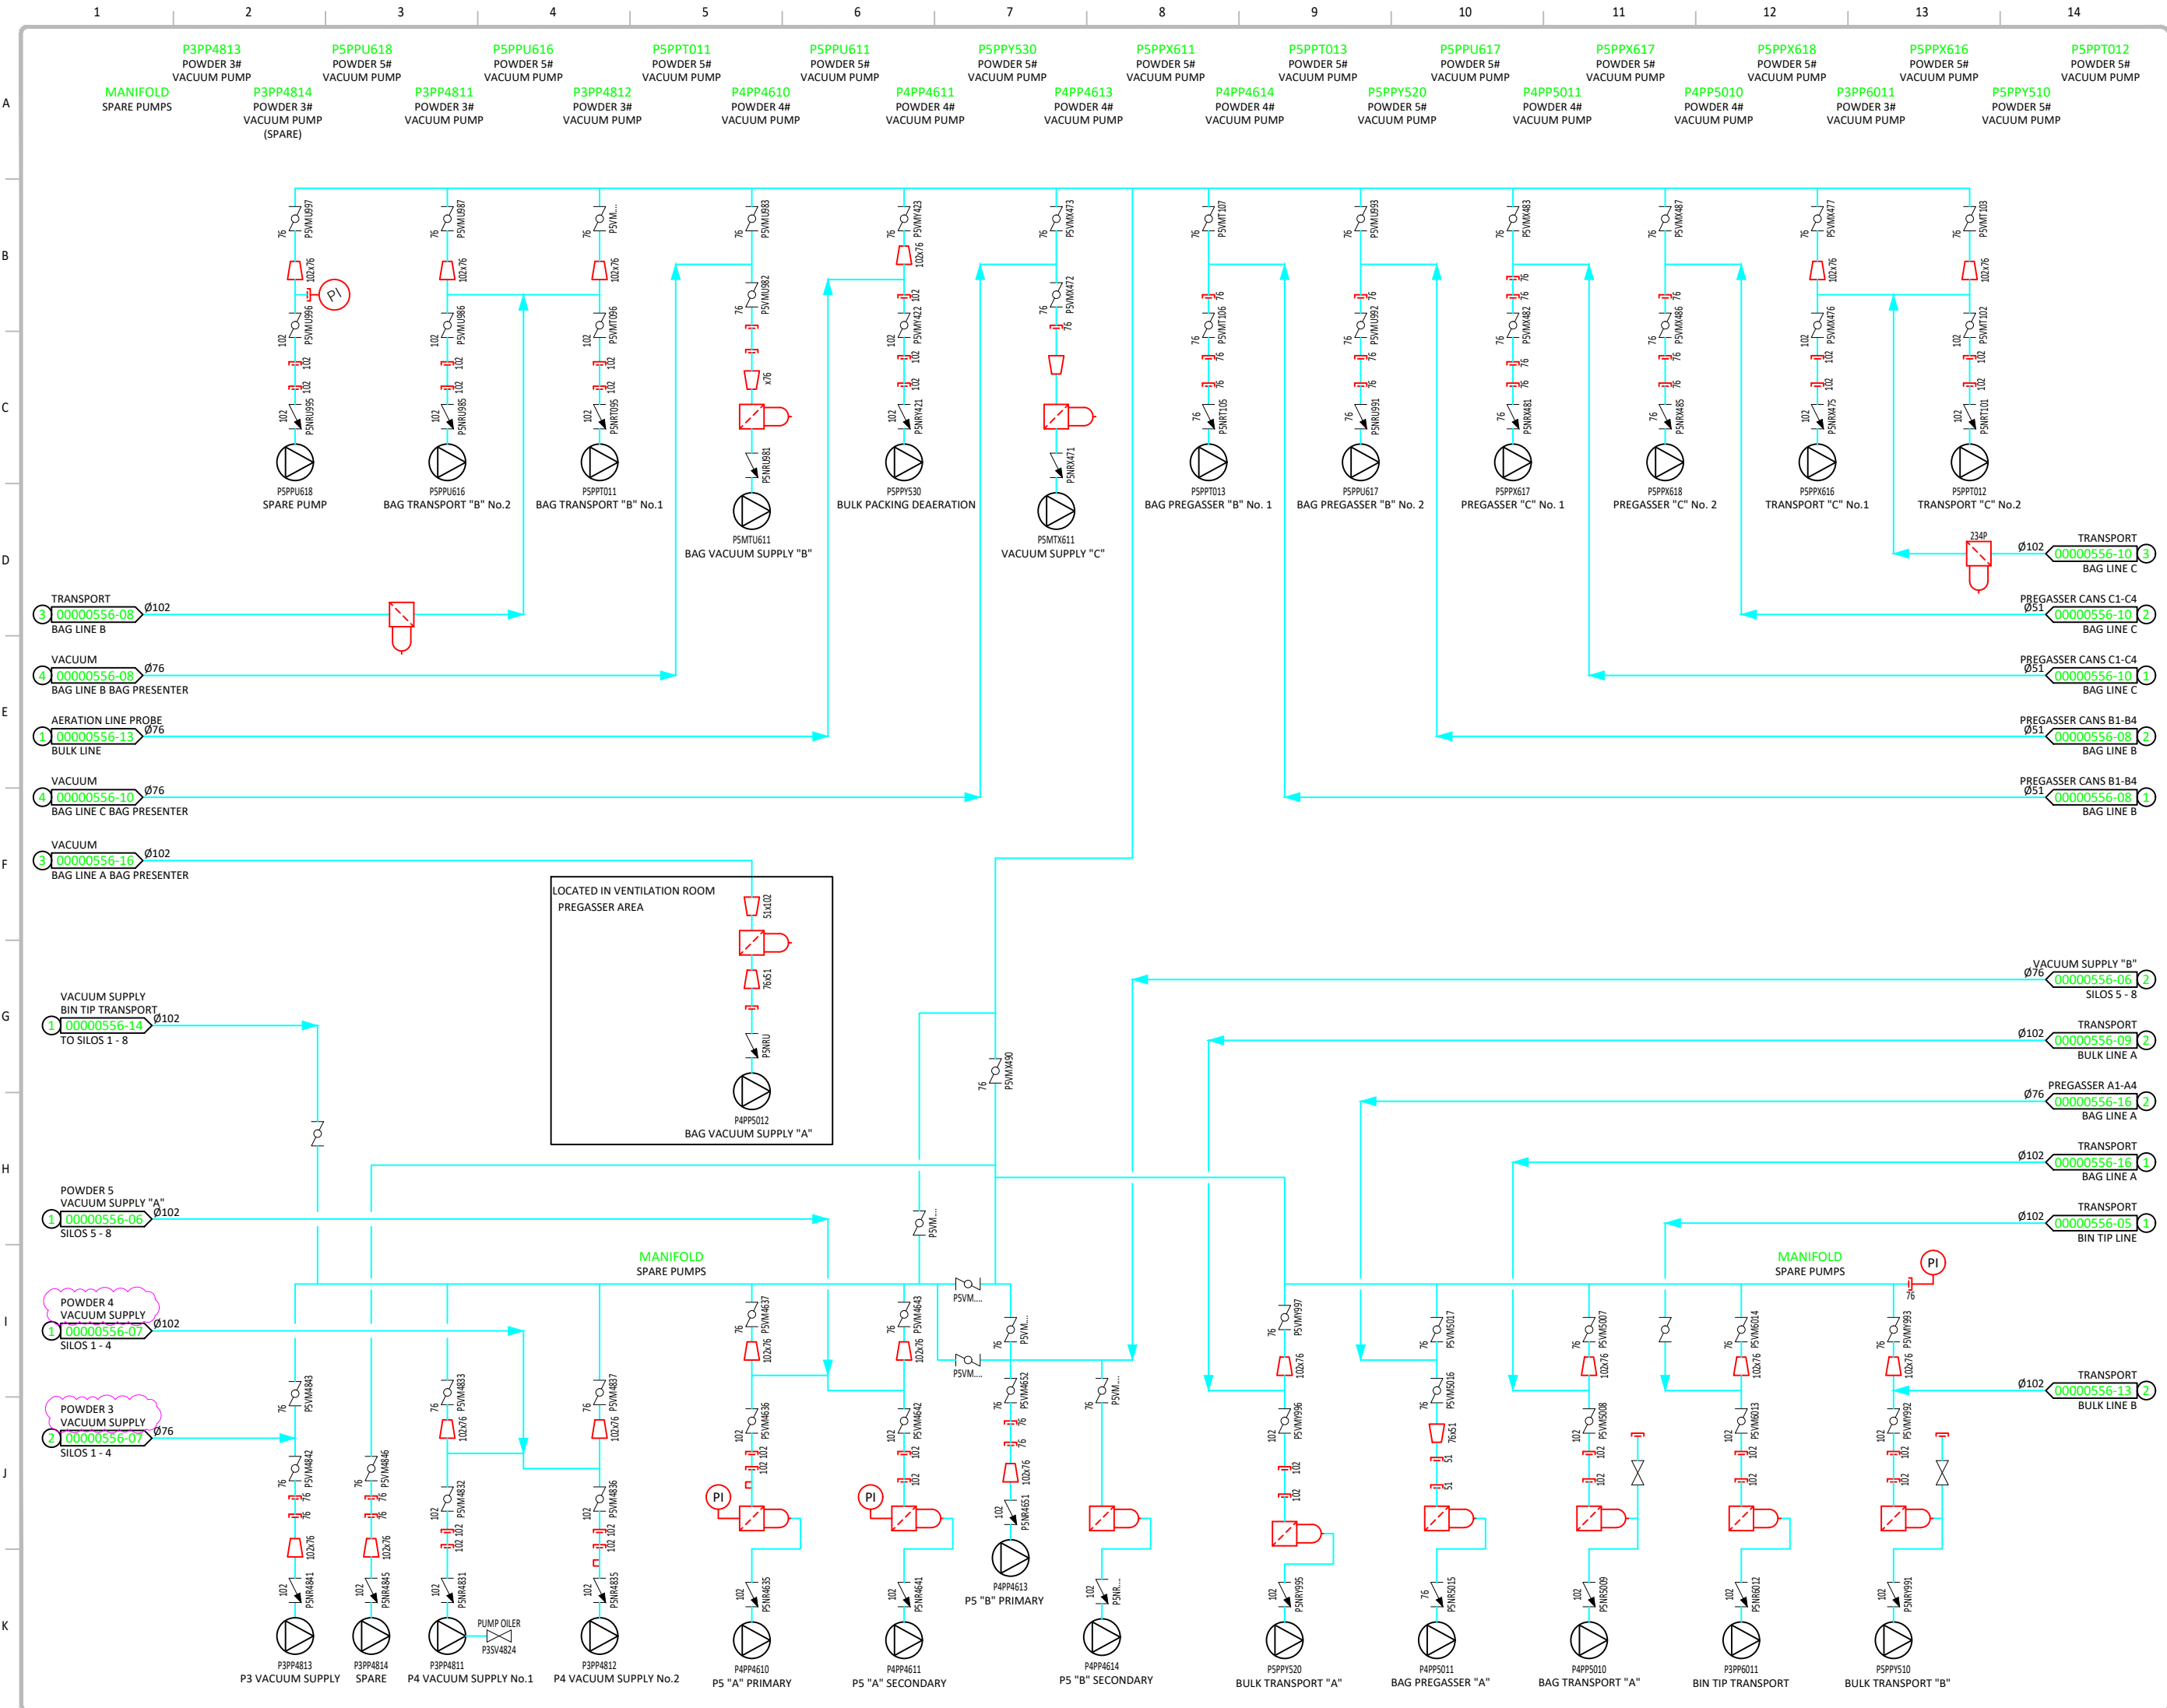

A1

NOTES:

COLBY

DWG - 43699P11

REFERENCE DRAWINGS

	FONTERRA PIPING/MECHANICAL LEGEND SHEETS
	FONTERRA P&ID LEGEND SHEETS
00000556-06	SILOS 5-6 & SEPARATORS P&ID
00000556-07	SILOS 1-4 & SEPARATORS P&ID
00000556-08	PREGASSING SYSTEM "B" 25KG BAG LINE P&ID
00000556-09	BULK PACKER HOPPER "A"
00000556-10	PREGASSING SYSTEM "C" 25KG BAG LINE P&ID
00000556-13	BULK PACKER HOPPER B POWDER 5#
00000556-16	PREGASSING SYSTEM "A" 25KG BAG LINE P&ID
00000556-05	BIN TIPPER P&ID

REVISIONS

NO.	DESCRIPTION	DATE
4	ISSUED - Mohamed.Chaar@tetrapak.com	SAC 11.06.2024
3	AS BUILT - Mohamed.Chaar@tetrapak.com	MC 10.04.2024
2	ISSUED - Henri.Viljoen@tetrapak.com	SAC 21.11.2023
E	FORMAT UPDATE	SAC 25.11.2021
D	CONTINUATIONS & TAG UPDATES	HIM 06.04.2016
C	SAPHT UPDATE/TITLE	SAR 12.08.2010
B	FORMATTING UPDATE	DRK 04.12.2001
A	AS BUILT MARK UPS	DRK 29.10.2001

DO NOT SCALE
REPORT ALL ERRORS



.VFonterra_rjb_std_L.PNG

DELETED THIS BLOCK AND
ADD YOUR COMPANY
LOGO HERE

COPYRIGHT:
THIS DRAWING IS THE EXCLUSIVE
PROPERTY OF FONTERRA. IT MUST
NOT BE COPIED BY ANY MEANS,
WITHOUT THE WRITTEN CONSENT
OF FONTERRA DRAWING CONTROL.

Drawn COLBY	Date 02.12.1997
Checked COLBY	Scale NTS

Title:
FONTERRA WHAREROA
POWDER 5
VACUUM PUMPS
P&ID

Dwg No. SITE WH	00000556 - 11 PLANT P5	Rev DISCIPLINE PI	TYPE S	4
--------------------	---------------------------	----------------------	--------	---