


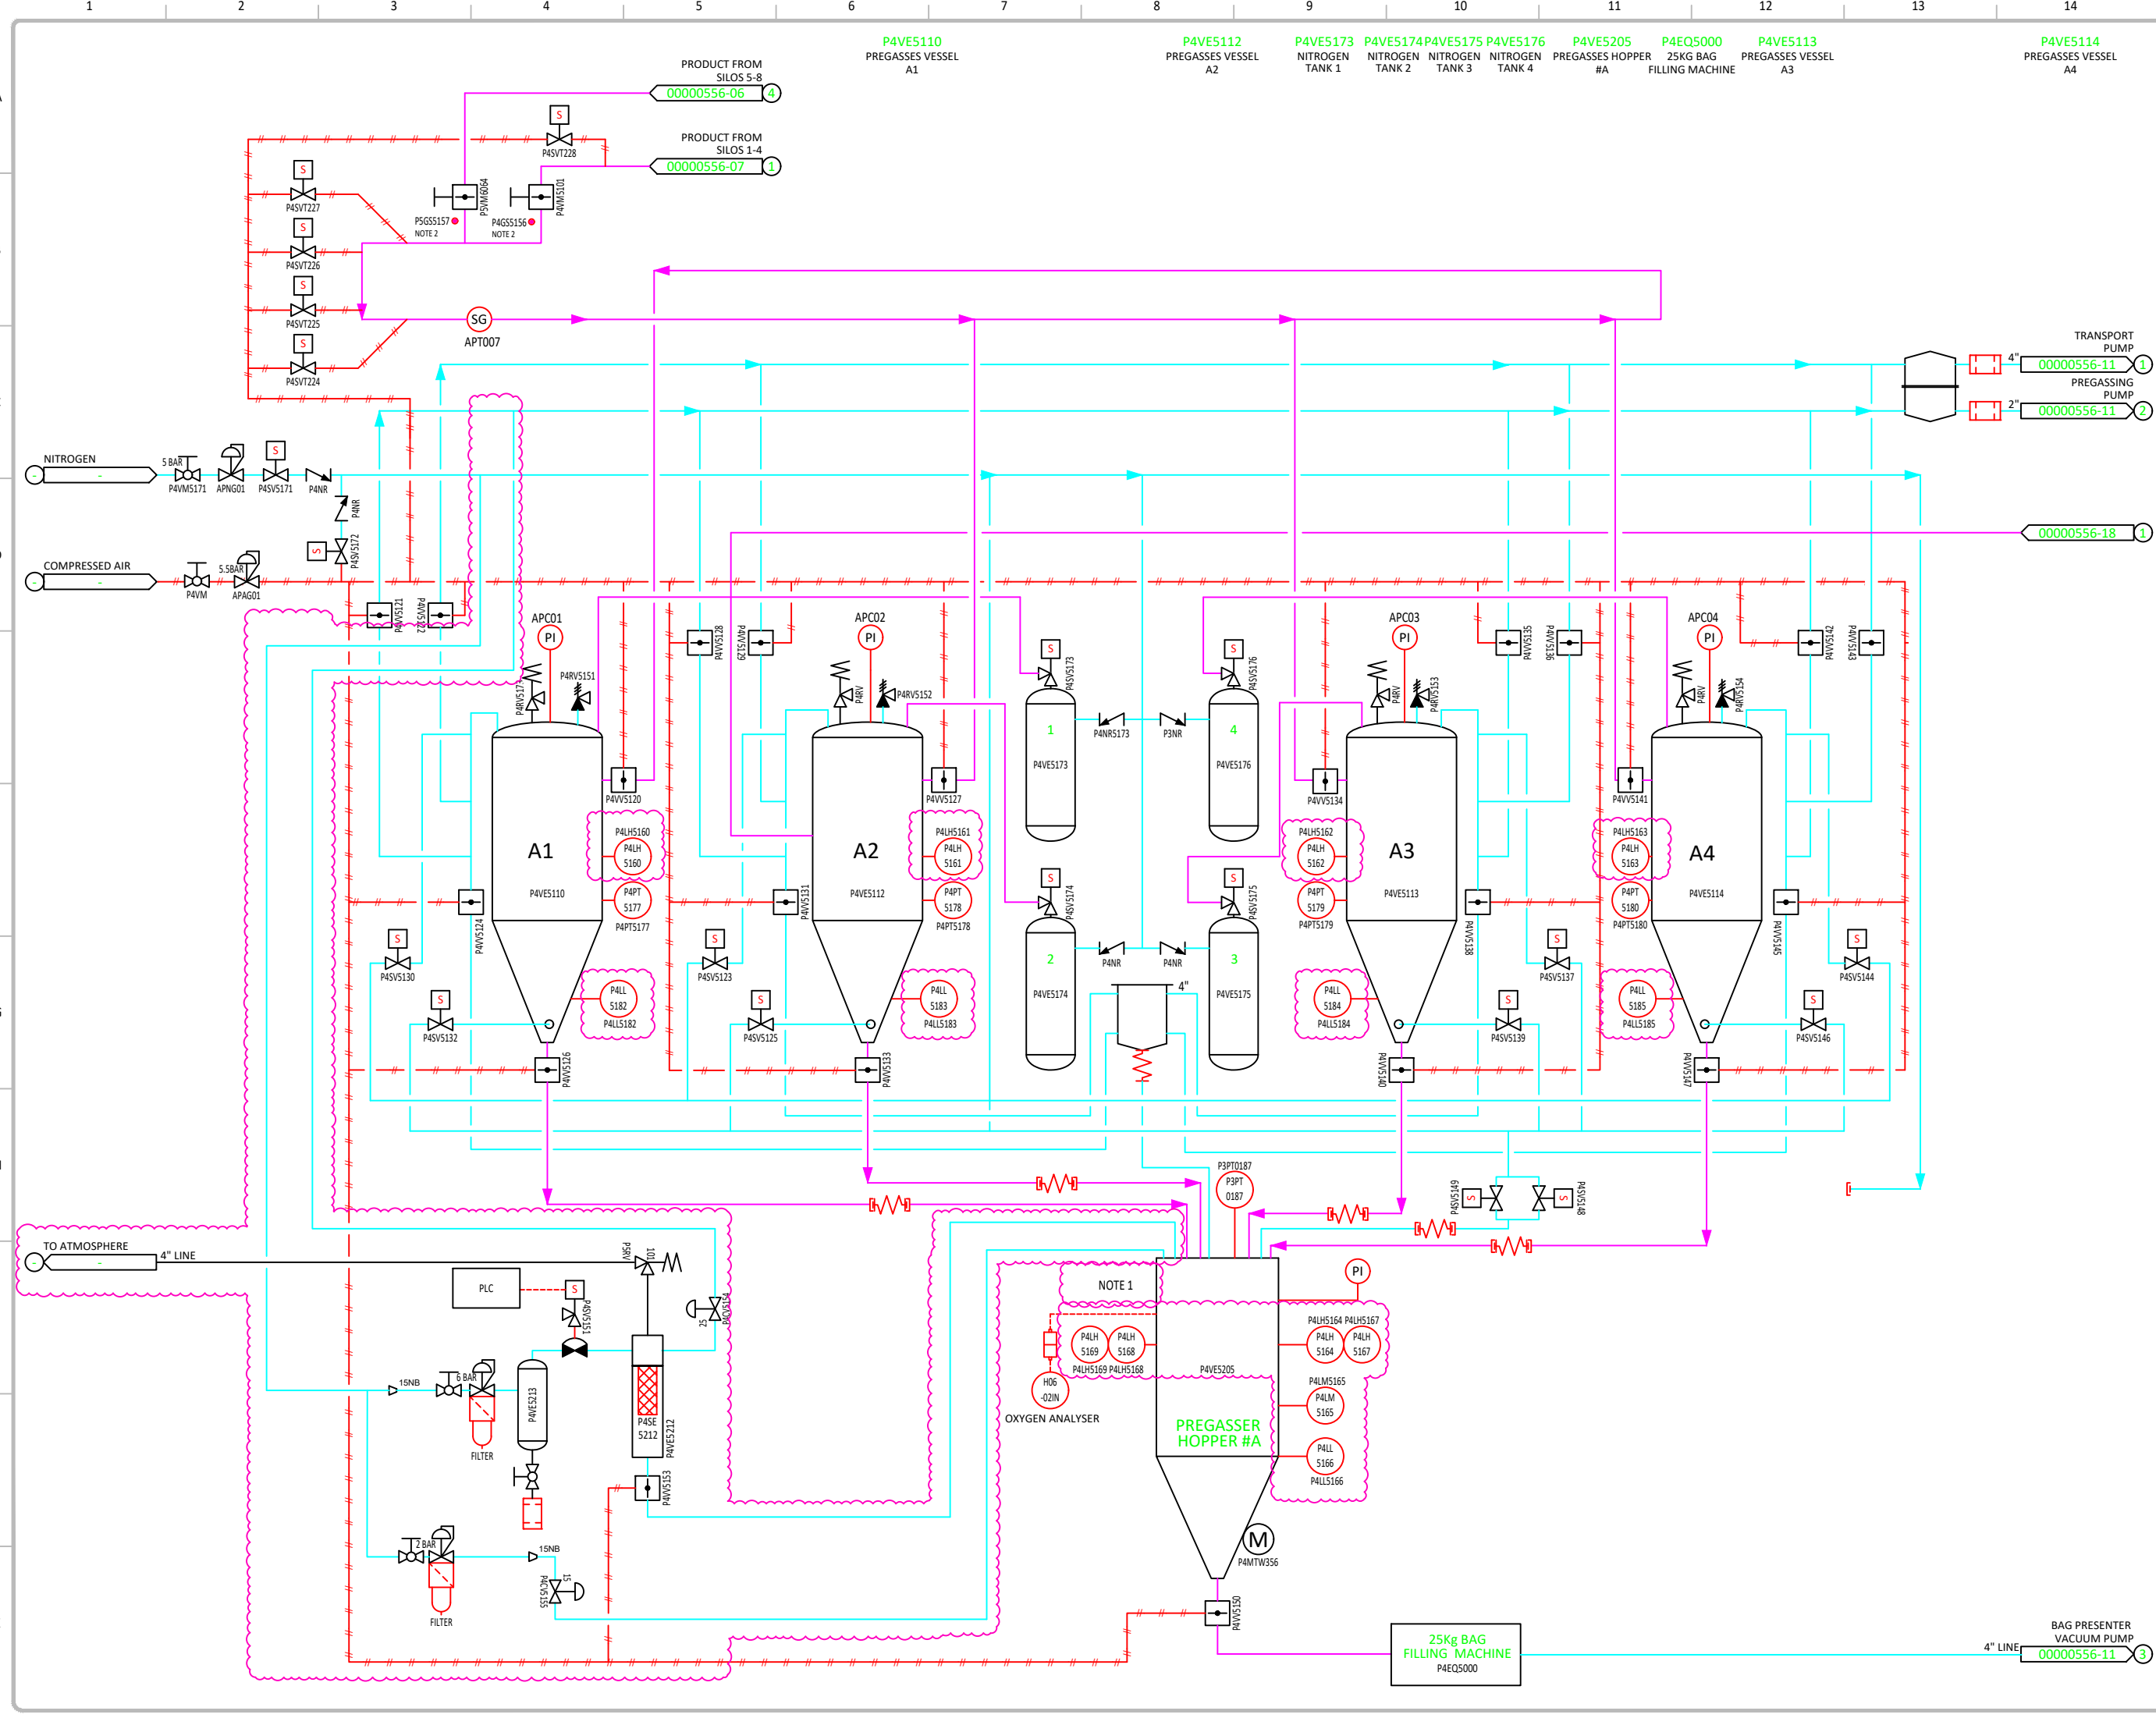

A1

NOTES:

- 1. REMOVED P4LHT259 HOPPER HIGH LEVEL
- 2. ACTIVATED WHEN VALVE CLOSED

COLBY

DWG - 43699P10

REFERENCE DRAWINGS

	FONTERRA PIPING/MECHANICAL LEGEND SHEETS
	FONTERRA P&ID LEGEND SHEETS
00000556-06	POWDER S SILOS 5 & 6 & SEPARATORS P&ID
00000556-07	POWDER S SILOS 1-4 & SEPARATORS P&ID
00000556-11	POWDER S VACUUM PUMPS P&ID
	COMPRESSED AIR SUPPLY
	NITROGEN SUPPLY
	(FUTURE DWG) 25KG BAGGING MACHINE P&ID

REVISIONS

6	AS BUILT - ben.walkley@tetrapak.com	RFI	25.07.2025
H	UPDATES - BRENDON FISCHER	SAC	21.09.2021
5	ISSUED - Reed.Fisher@tetrapak.com	SAC	17.02.2025
K	AS BUILT - Mohamed.Chaar@tetrapak.com	SAC	13.11.2024
4	ISSUED - Mohamed.Chaar@tetrapak.com	SAC	10.06.2024
J	AS BUILT - TETRA PAK	SAC	16.04.2024
3	ISSUED - Henri.Viljoen@tetrapak.com	SAC	21.11.2023
I	AS BUILT & FORMAT UPDATE	SAC	25.10.2022
2	AS BUILT - TRANSPORT LINES PROJECT	MCH	20.06.2022

DO NOT SCALE
REPORT ALL ERRORS

Fonterra

Copyright:

THIS DRAWING IS THE EXCLUSIVE PROPERTY OF FONTERRA. IT MUST NOT BE COPIED BY ANY MEANS, WITHOUT THE WRITTEN CONSENT OF FONTERRA DRAWING CONTROL.

Drawn

COLBY

Checked

COLBY

Date

07.01.1996

Scale

NTS

Title:

WHAREROA POWDER 4
25 KG BAG LINE "A"
PREGASSING SYSTEM A
P&ID

Dwg No.

00000556-16

Site

WH

Plant

P5

Discipline

PI

Type

S

Rev

6