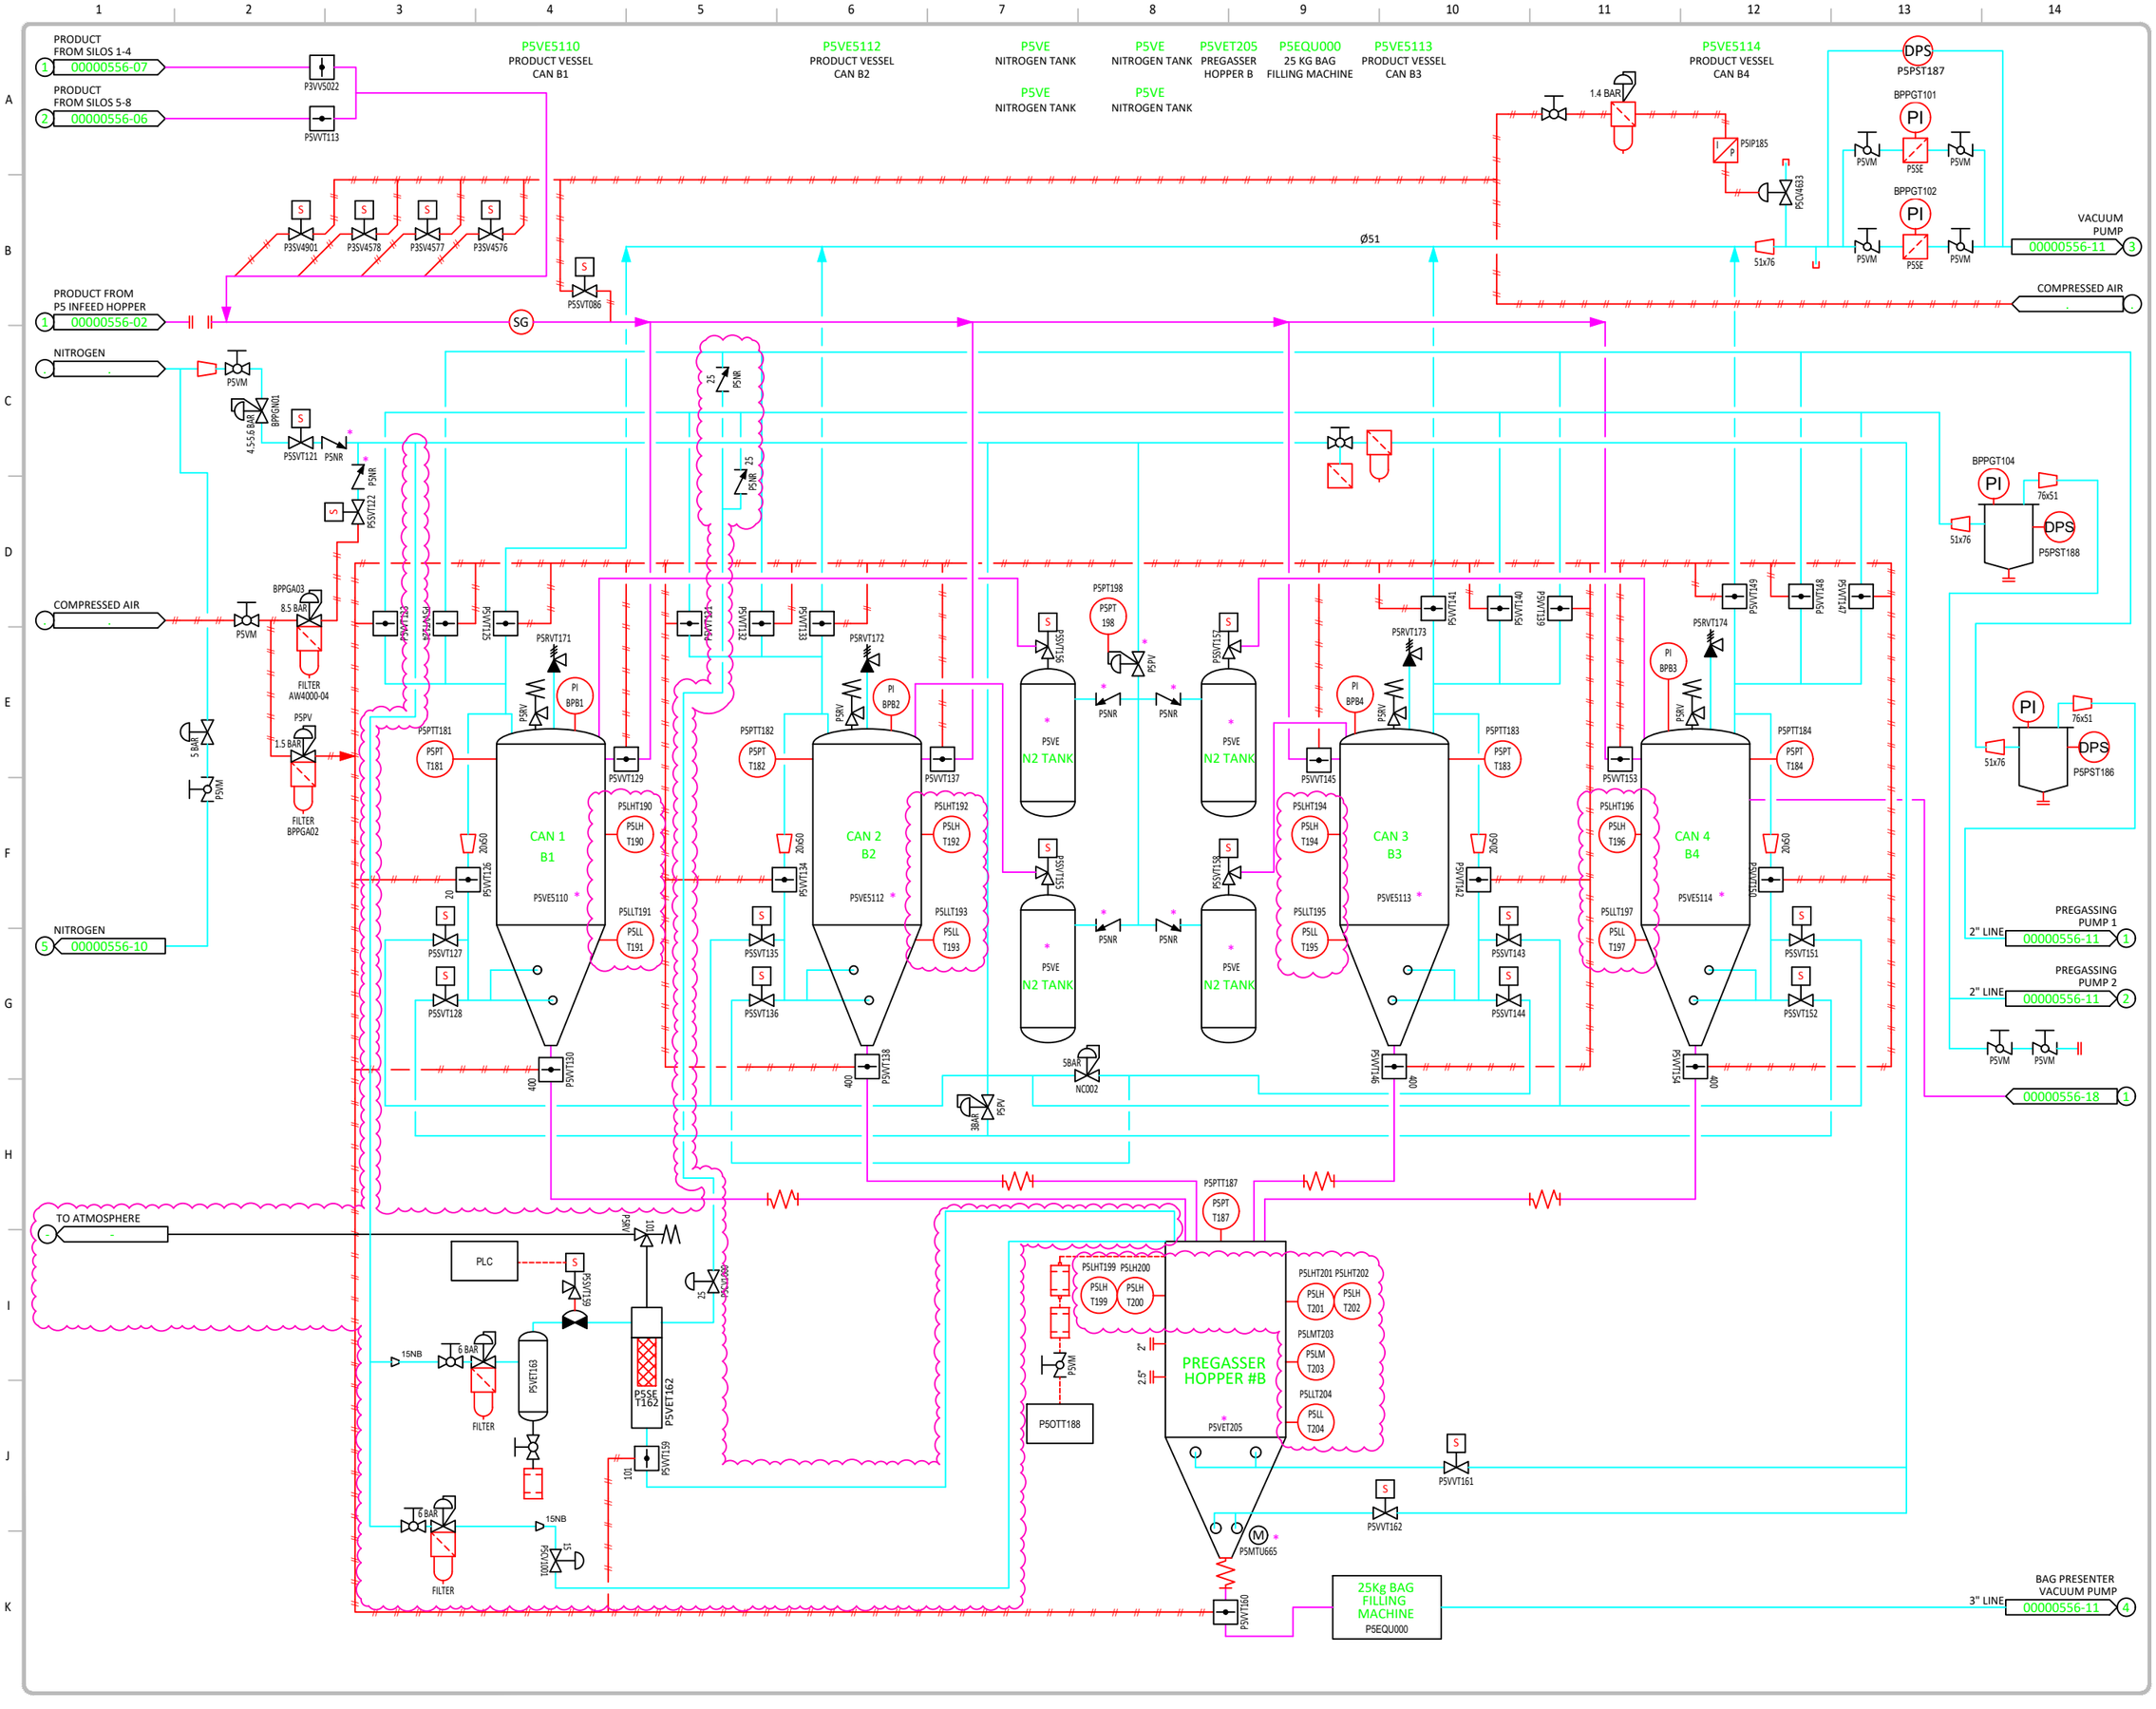

A1

NOTES:

* METAL MAPPING POTENTIAL CONTAMINATION POINT

Have tried to match tags to SAP. Confirm in field if possible.

REFERENCE DRAWINGS	
	FONTERRA PIPING/MECHANICAL LEGEND SHEETS
	FONTERRA P&ID LEGEND SHEETS
00000556-02	POWDER 5 INFEED HOPPER
00000556-06	POWDER 5 SILOS 5 & 6 & SEPARATORS
00000556-07	POWDER 5 SILOS 1-4 & SEPARATORS
00000556-11	POWDER 5 VACUUM PUMPS
	COMPRESSED AIR
	NITROGEN
	(FUTURE DWG) 25KG BAGGING MACHINE P&ID

6	AS BUILT - ben.walkley@tetrapak.com	RFI	25.07.2025
5	ISSUED - Reed.Fisher@tetrapak.com	SAC	17.03.2025
K	AS BUILT - TETRA PAK	SAC	16.12.2024
4	ISSUED - Mohamed.Chaar@tetrapak.com	SAC	10.06.2024
3	AS BUILT - Mohamed.Chaar@tetrapak.com	MC	10.04.2024
2	ISSUED - Henri.Viljoen@tetrapak.com	SAC	21.11.2023
J	FORMAT UPDATE	SAC	27.10.2022
1	REV 6 - AS BUILT	MCH	20.06.2022
I	UPDATES - BRENDON FISCHER	SAC	21.09.2021

REVISIONS

DO NOT SCALE
REPORT ALL ERRORS

AUTOCAD 2023

.\Fonterra_rgb_std_L.PNG

Tetra Pak
PROTECTS WHAT'S GOOD

COPYRIGHT:
THIS DRAWING IS THE EXCLUSIVE PROPERTY OF FONTERRA. IT MUST NOT BE COPIED BY ANY MEANS, WITHOUT THE WRITTEN CONSENT OF FONTERRA DRAWING CONTROL.

Drawn	Date
COLBY	07.01.1996
Checked	Scale
COLBY	NTS

Title.
WHAREROA POWDER 5
25KG BAG LINE "B"
PREGASSING SYSTEM B
P&ID

Dwg No. 00000556 -08 Rev 6

SITE	PLANT	DISCIPLINE	TYPE
WH	P5	PI	S