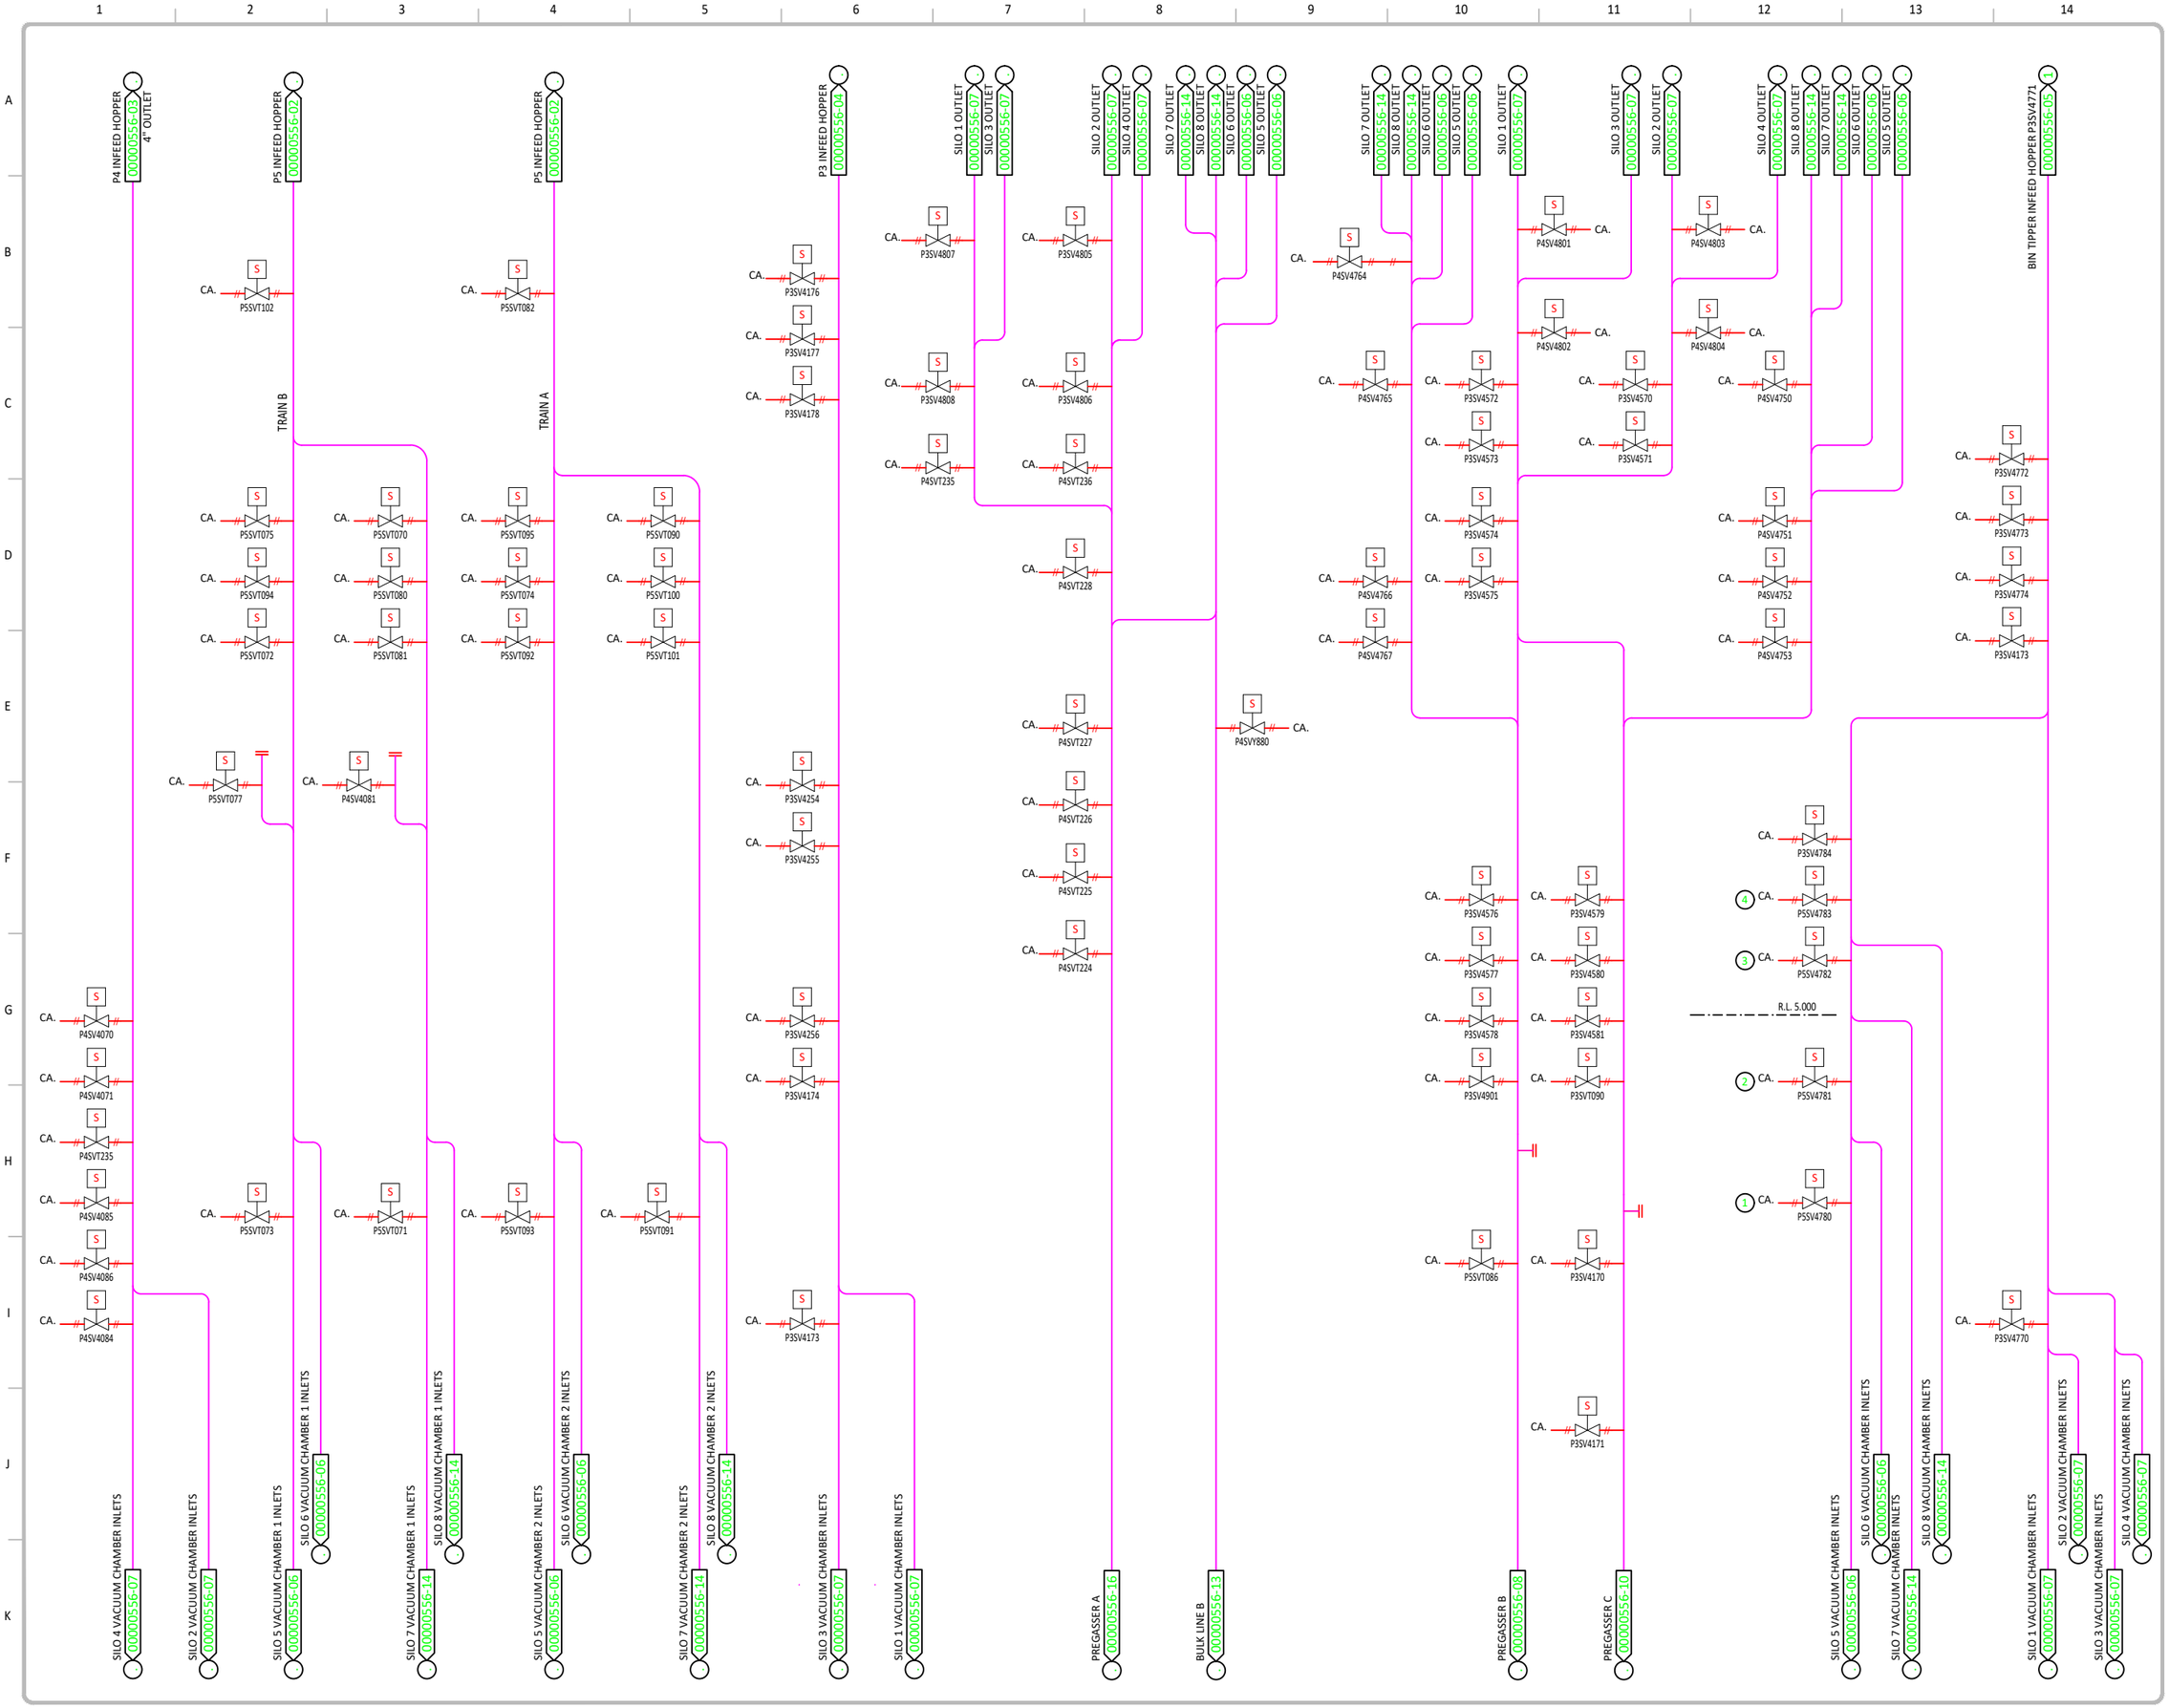

A1

NOTES:

COLBY

DWG - 43699P52

REFERENCE DRAWINGS	
	FONTERRA PIPING/MECHANICAL LEGEND SHEETS
	FONTERRA P&ID LEGEND SHEETS
00000556-02	POWDER 5 INFEED HOPPER

4	ISSUED - Mohamed.Chaar@tetrapak.com	SAC	11.06.2024
3	AS BUILT - Mohamed.Chaar@tetrapak.com	MC	10.04.2024
2	ISSUED - Henri.Viljoen@tetrapak.com	SAC	21.112023
D	FORMAT UPDATE	SAC	24.11.2021
C	CONTINUATIONS	HIM	09.06.2016
B	SAPHT UPDATE/TITLE	SAR	12.08.2010
A	AS BUILT MARK UPS	DRK	29.10.2001
1	UPDATED TO KIWI SPEC	DRK	02.09.99

REVISIONS

DO NOT SCALE
REPORT ALL ERRORS

AUTOCAD 2023

.\Fonterra_rgb_std_L.PNG

DELETED THIS BLOCK AND
ADD YOUR COMPANY LOGO HERE

COPYRIGHT:
THIS DRAWING IS THE EXCLUSIVE PROPERTY OF FONTERRA. IT MUST NOT BE COPIED BY ANY MEANS, WITHOUT THE WRITTEN CONSENT OF FONTERRA DRAWING CONTROL.

Drawn	Date
MBL	05.03.97
Checked	Scale
MBL	NTS

Title.
FONTERRA WHAREROA
POWDER 5
LINE INJECTORS
P&ID

Dwg No. 00000556 - 12 Rev 4

SITE	PLANT	DISCIPLINE	TYPE
WH	P5	PI	S