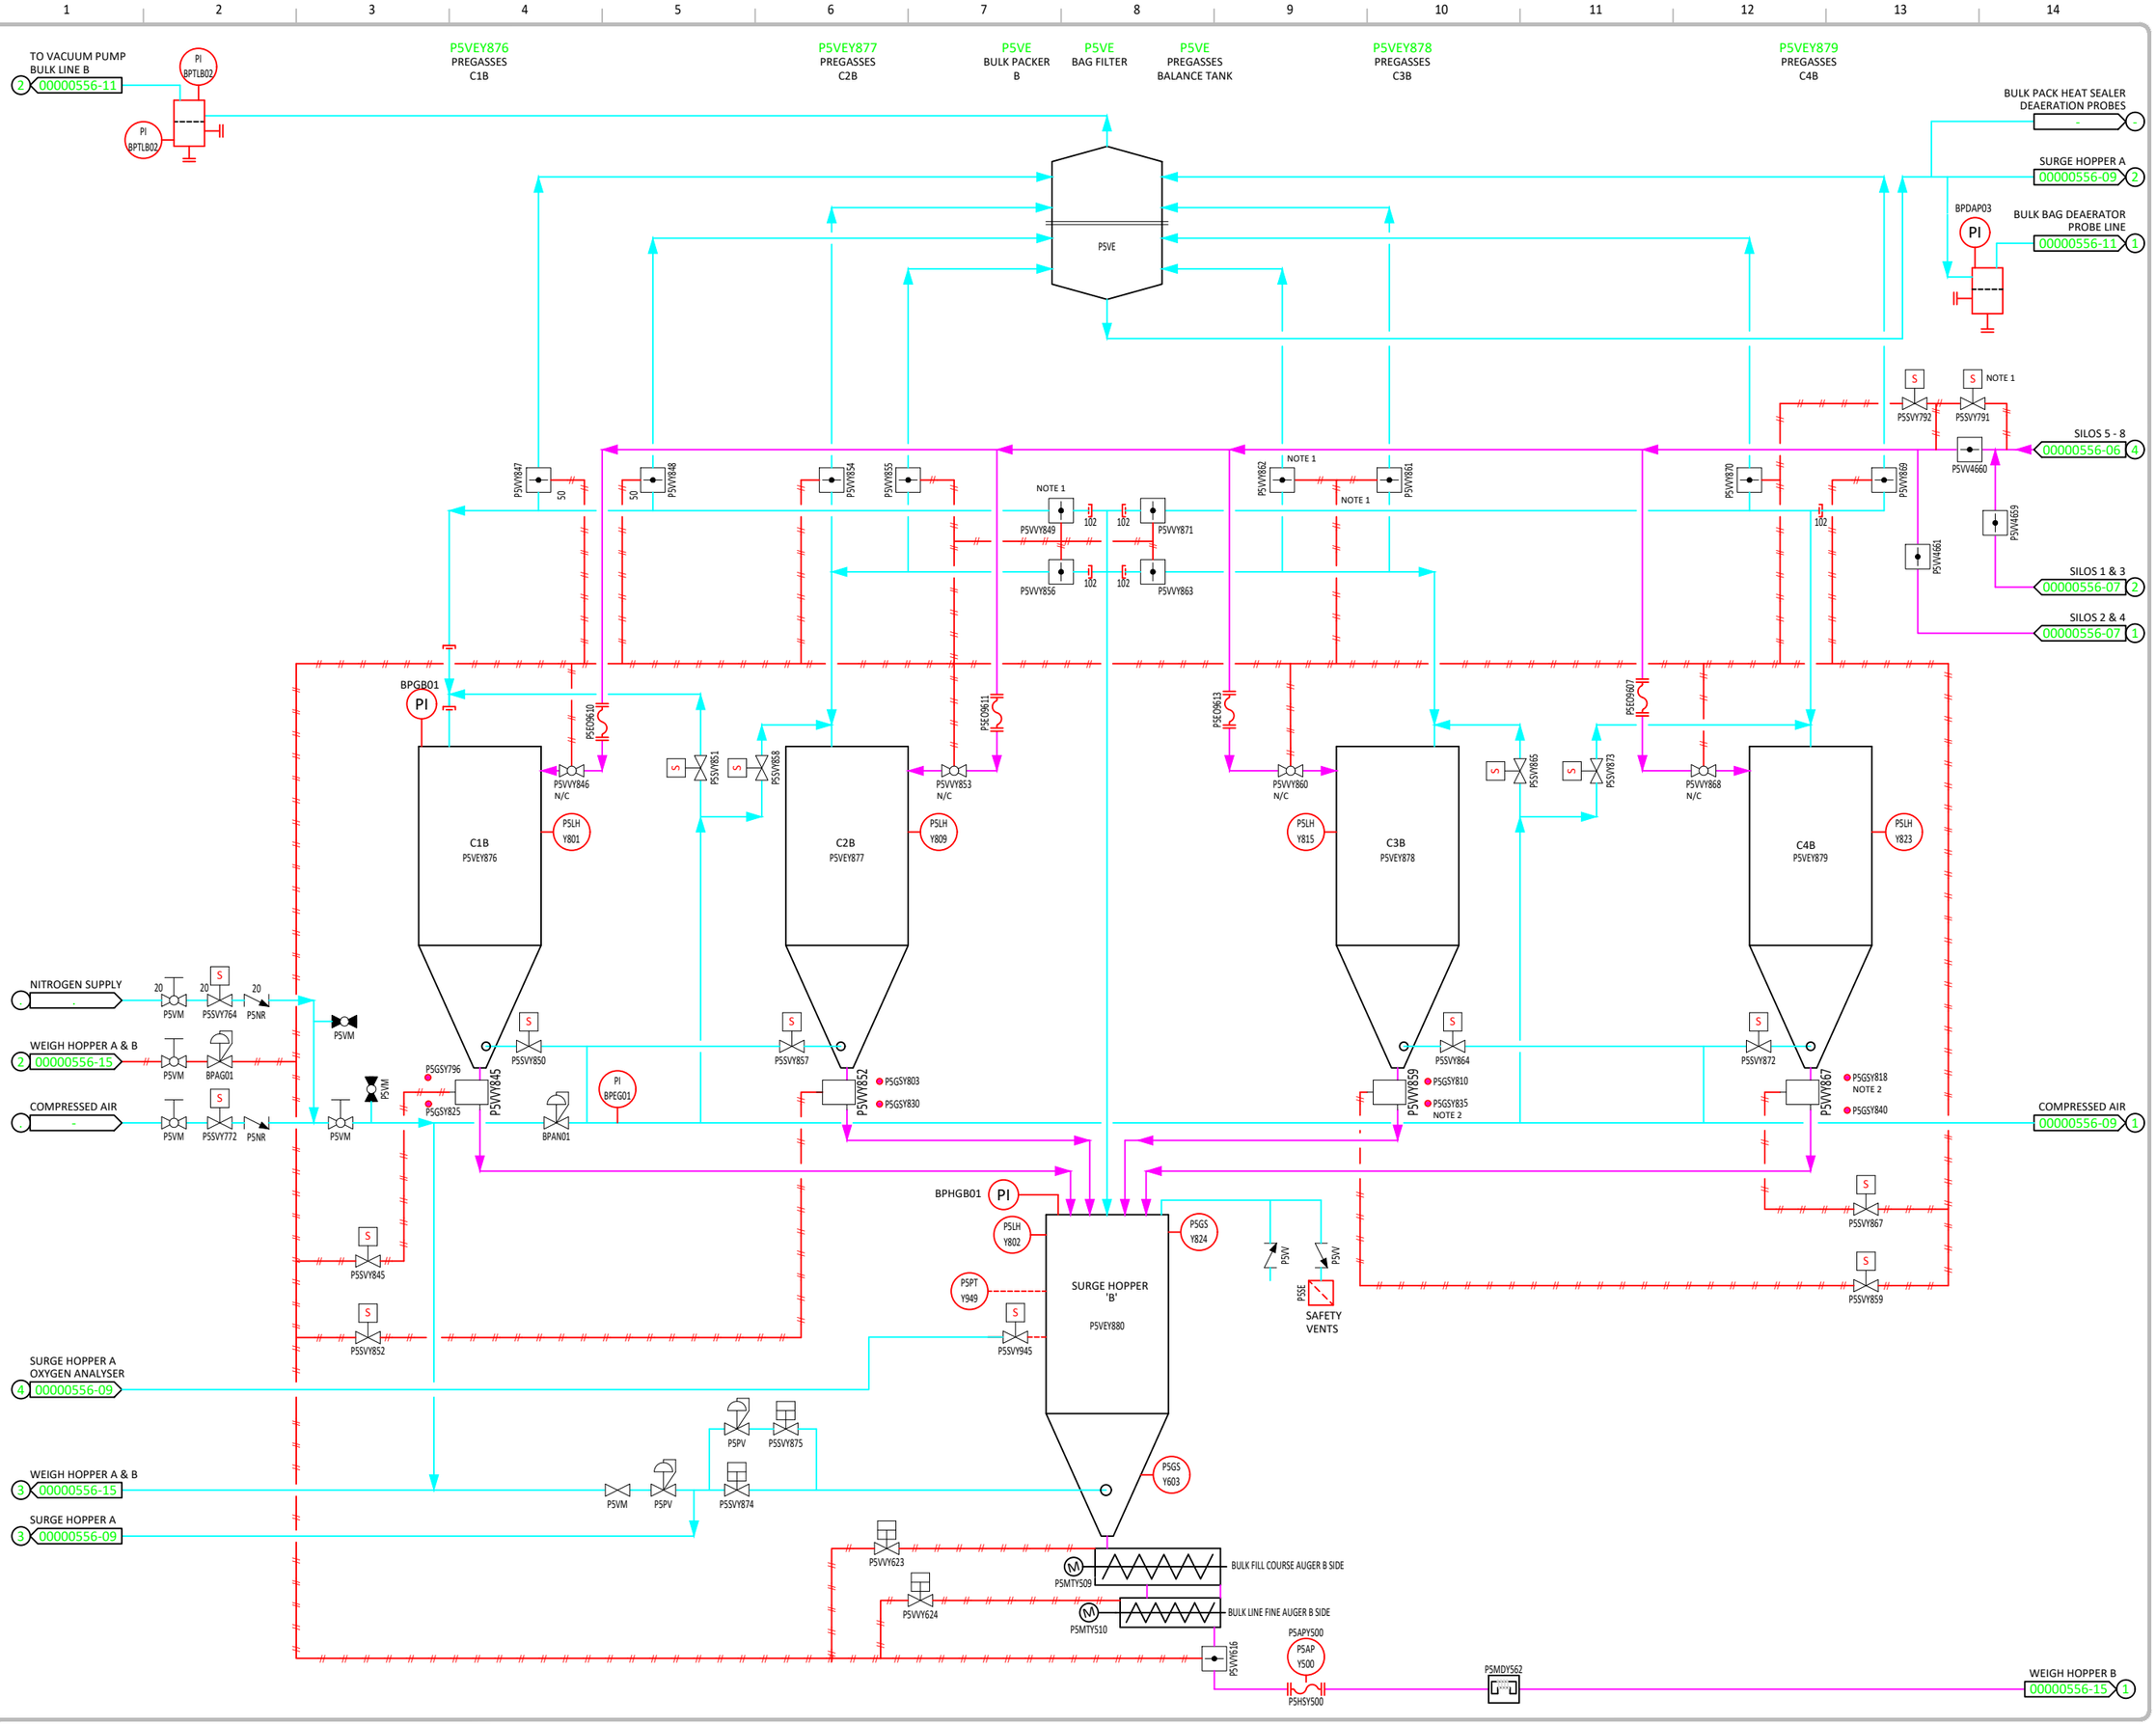

A1

NOTES:

1. TAG COULD NOT BE REACHED OR FOUND IN THE FIELD.
2. NO LABEL ON PROXY IN FIELD

REFERENCE DRAWINGS	
	FONTERRA PIPING/MECHANICAL LEGEND SHEETS
	FONTERRA P&ID LEGEND SHEETS

3	AS BUILT - Mohamed.Chaar@tetrapak.com	MC	10.04.2024
2	ISSUED - Henri.Viljoen@tetrapak.com	SAC	21.11.2023
G	FORMAT UPDATE	SAC	25.11.2021
F	METAL MAPPING & BLOCKS	HIM	08.06.2016
E	UPDATED TO FONTERRA MARKUPS	JNB	13.11.2012
D	UPDATED POST ISOLATE VALVE INSTALL	JNB	10.09.2012
C	SAPHT UPDATE/TITLE	SAR	12.08.2010
-			
4	ISSUED - Mohamed.Chaar@tetrapak.com	SAC	11.06.2024

REVISIONS

DO NOT SCALE
REPORT ALL ERRORS

.\Fonterra_rgb_std_L.PNG

DELETED THIS BLOCK AND
ADD YOUR COMPANY LOGO HERE

COPYRIGHT:
THIS DRAWING IS THE EXCLUSIVE PROPERTY OF FONTERRA. IT MUST NOT BE COPIED BY ANY MEANS, WITHOUT THE WRITTEN CONSENT OF FONTERRA DRAWING CONTROL.

Drawn	Date
D.KLENNER	14.04.99
Checked	Scale
	NTS

Title.
WHARERoA POWDER 5
BULK PACKER
HOPPER B
P&ID

Dwg No.	Rev
00000556 - 13	4

SITE	PLANT	DISCIPLINE	TYPE
WH	P5	PI	S