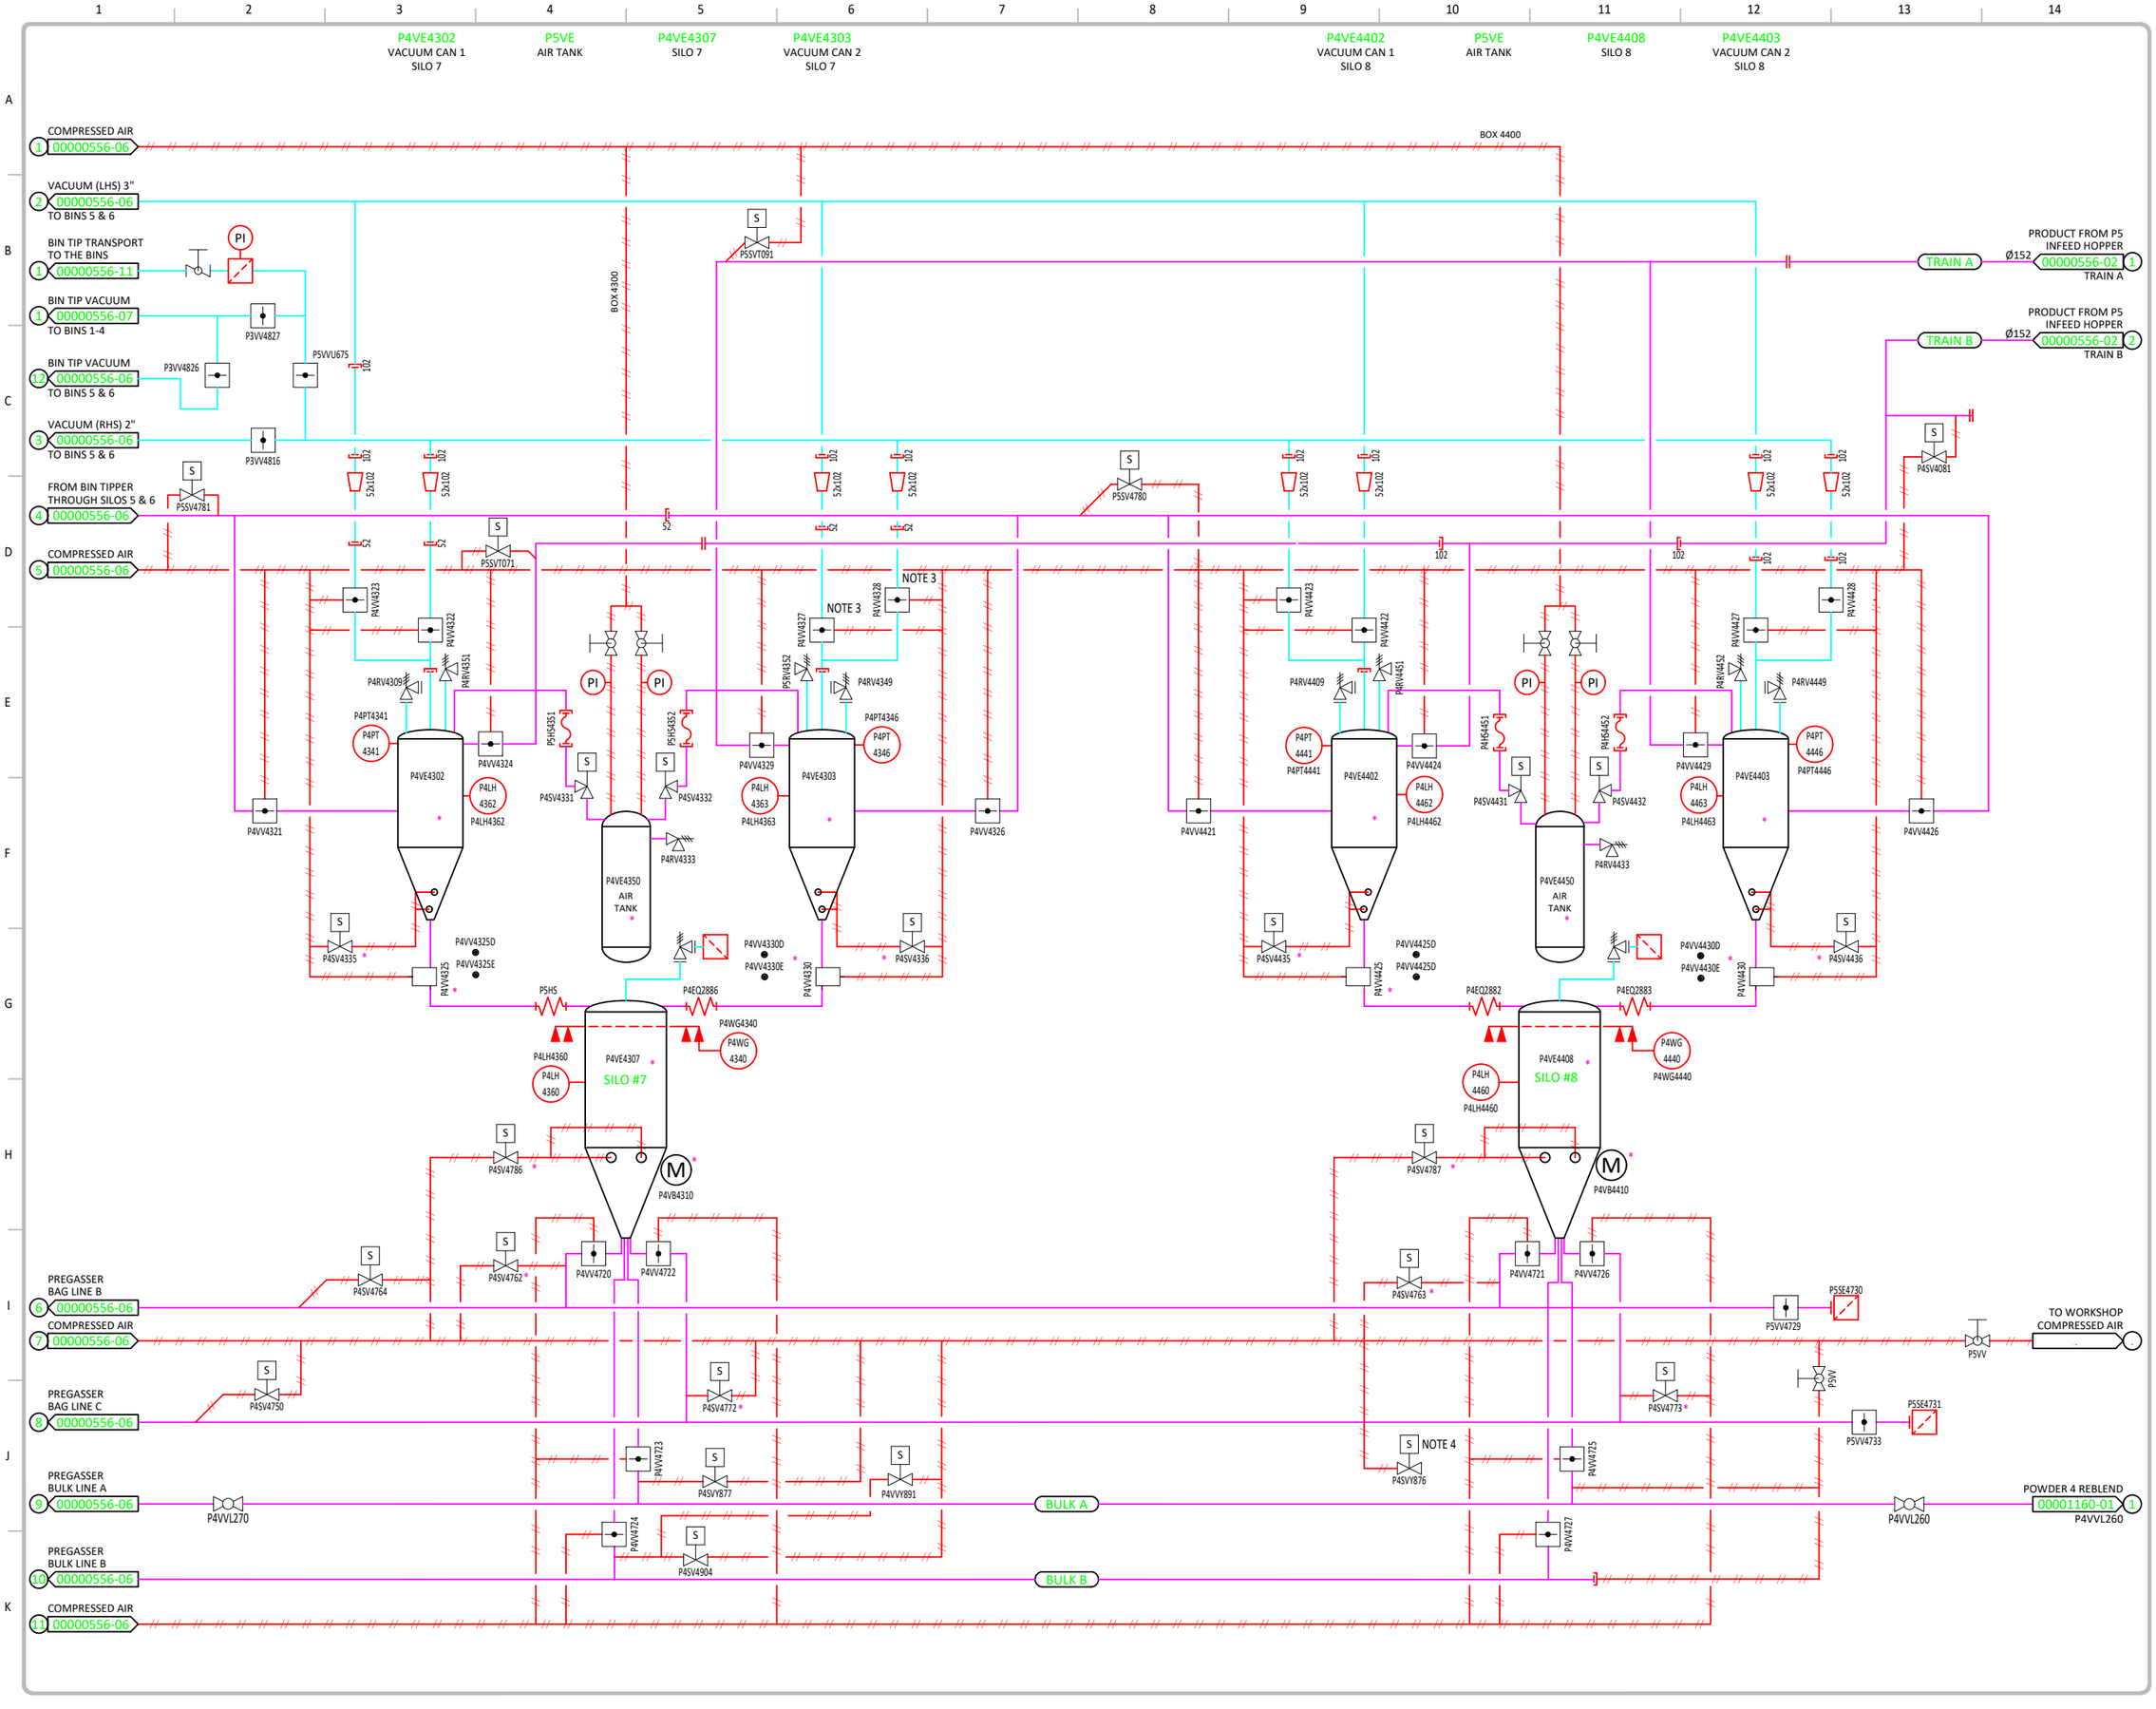

A1

NOTES:

* METAL MAPPING POTENTAL CONTAMINATION POINT.

3. TAG LABELS SWAPPED OVER ON SITE.
4. P4SVY876 PROCESS LINE DISCONNECTED
5. P4SVY890 & P4SV4905 ARE DISCONNECTED

COLBY
43699P06

REFERENCE DRAWINGS	
	FONTERRA PIPING MECHANICAL LEGEND SHEETS
	FONTERRA P&ID LEGEND SHEETS
00000556-02	POWDER 5 INFEED HOPPER P&ID
00000556-03	POWDER 4 INFEED HOPPER P&ID
00000556-05	POWDER 5 BIN TIPPER P7ID
00000556-06	POWDER 5 SILOS 5 & 6 & SEPARATORS P&ID
00001160-01	POWDER 4 REBLEND SYSTEM P&ID

B	CONTINUATIONS & BLOCKS	HIM	07.06.2016
8	UPDATED TO FONTERRA MARKUPS	JNB	13.11.2012
7	UPDATED TO FONTERRA MARKUPS	JNB	20.12.2011
11	ISSUED - Mohamed.Chaar@tetrapak.com	SAC	11.06.2024
10	AS BUILT - Mohamed.Chaar@tetrapak.com	SAC	10.04.2024
9	ISSUED - Henri.Viljoen@tetrapak.com	SAC	21.11.2023
D	UPDATES - BRENDON FISCHER	SAC	21.09.2021
C	UPDATE P4 TAGS	GT	01.10.2019

REVISIONS

DO NOT SCALE
REPORT ALL ERRORS

AUTOCAD 2023

.¥Fonterra_rgb_std_L.PNG

DELETED THIS BLOCK AND
ADD YOUR COMPANY LOGO HERE

COPYRIGHT:
THIS DRAWING IS THE EXCLUSIVE PROPERTY OF FONTERRA. IT MUST NOT BE COPIED BY ANY MEANS, WITHOUT THE WRITTEN CONSENT OF FONTERRA DRAWING CONTROL.

Drawn	Date
COLBY	09.01.97
Checked	**Scale**
COLBY	NTS

Title.
WHAREROA POWDER 5
SILOS 7 & 8
& SEPARATORS
P&ID

Dwg No. 00000556 - 14 Rev 11

SITE	PLANT	DISCIPLINE	TYPE
WH	P5	PI	S