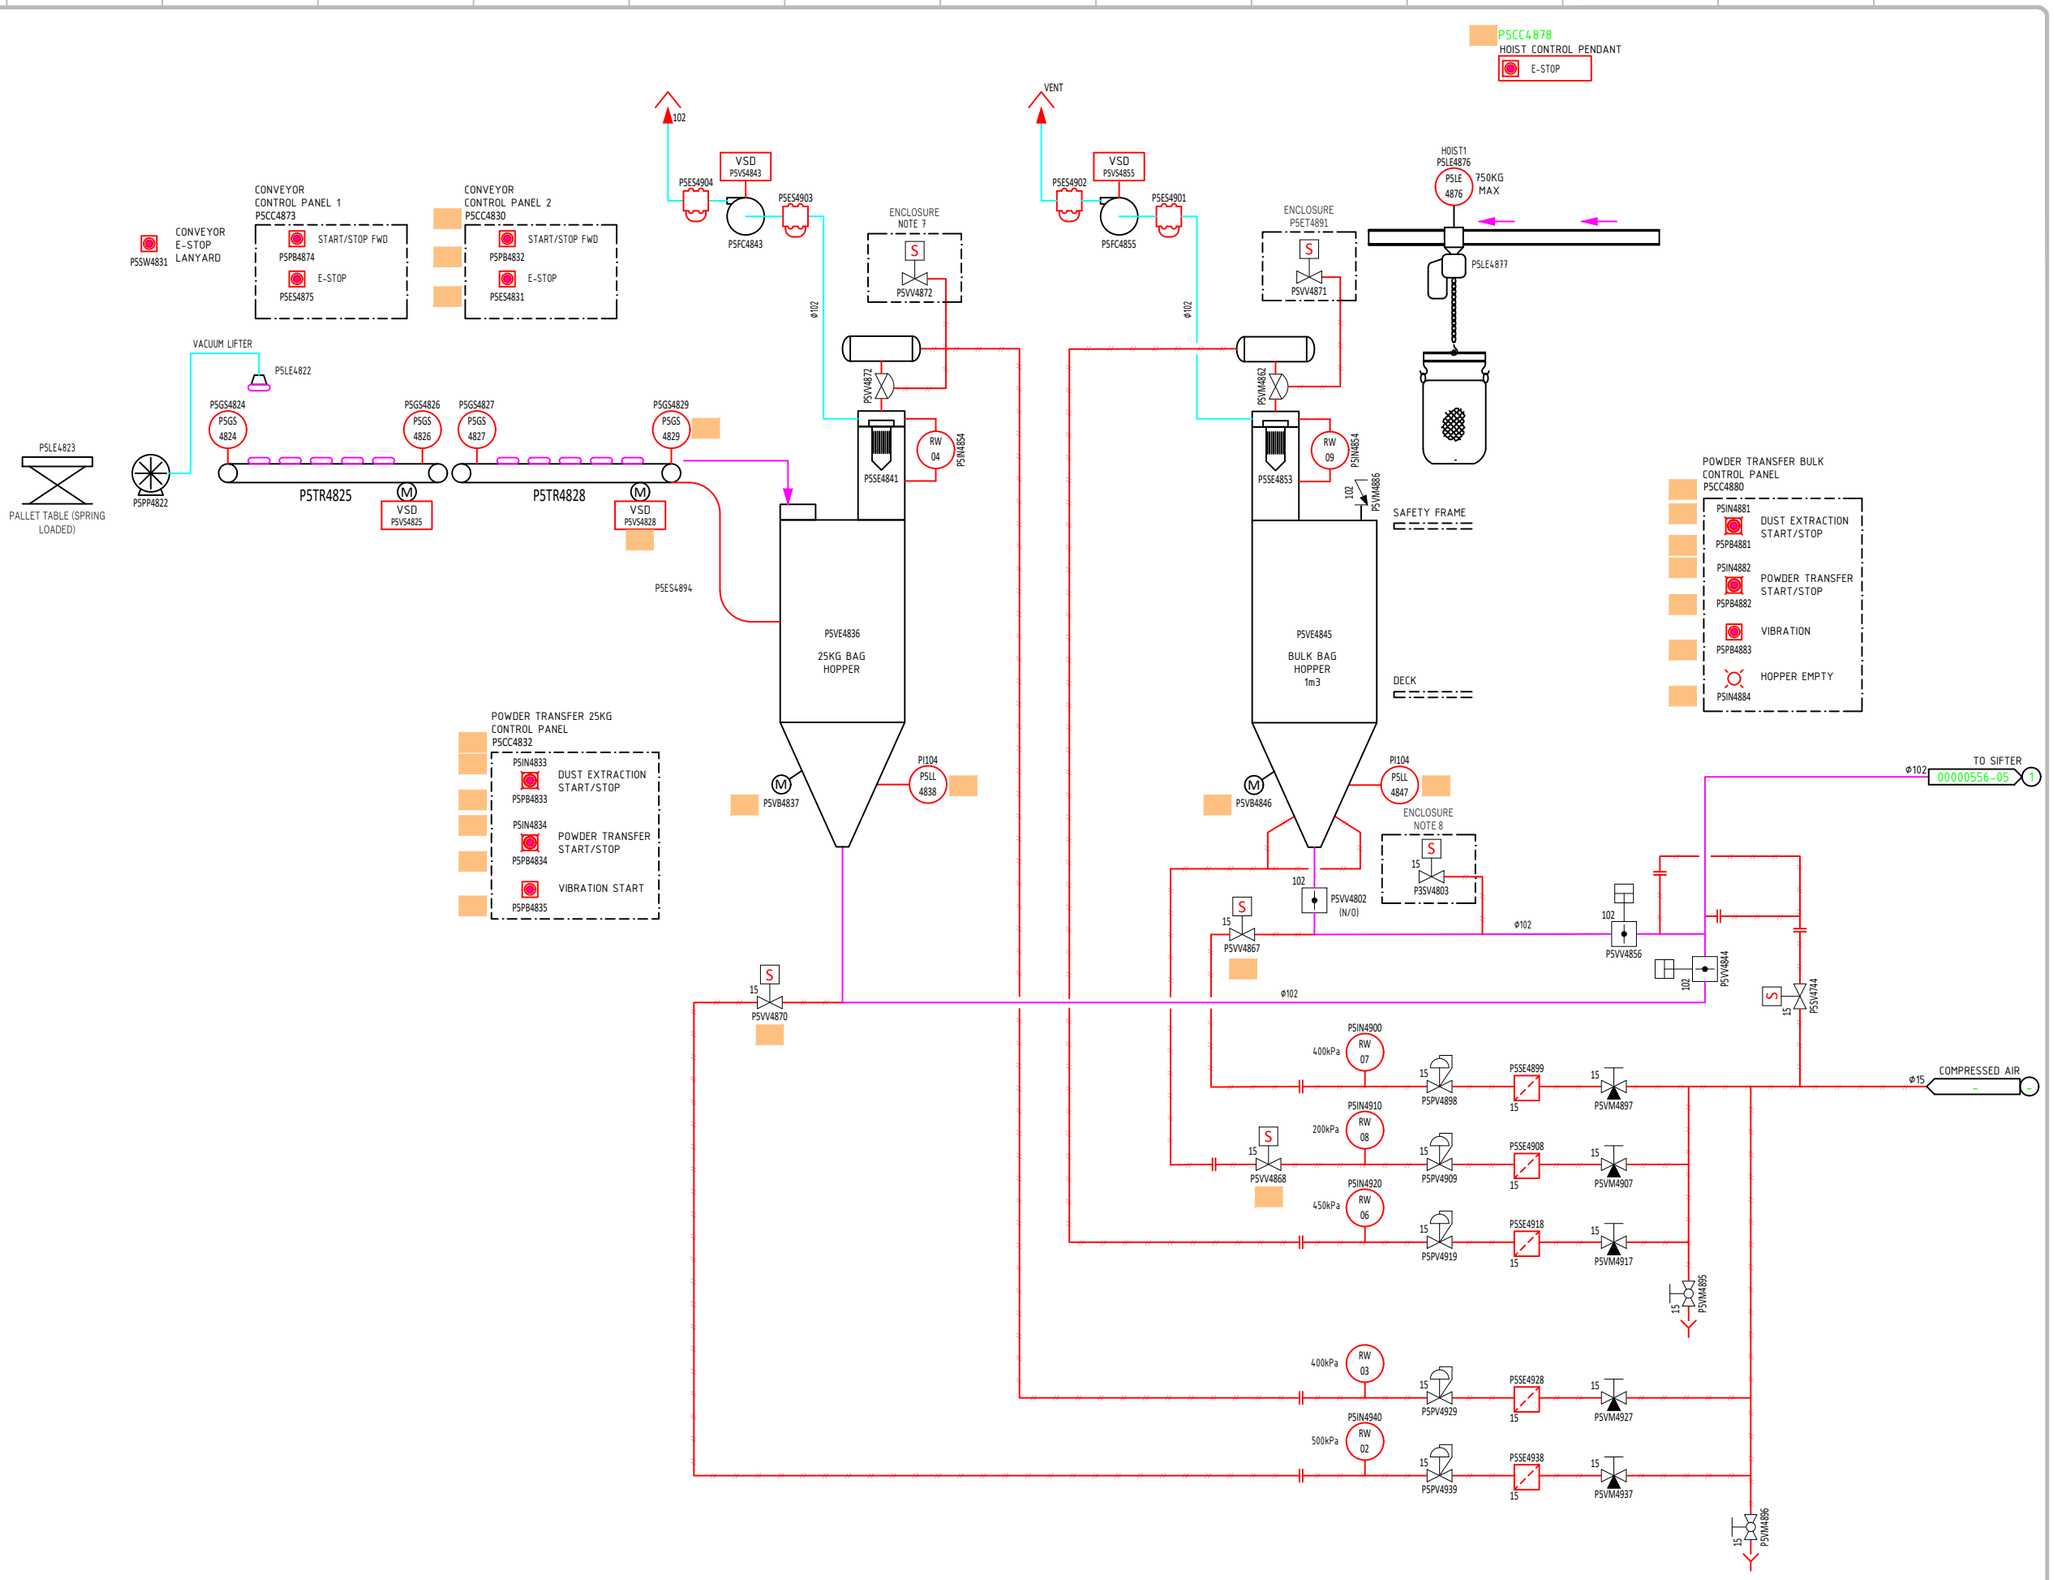

A1

NOTES:

1. ALL SANITARY VALVES ARE PISTON ACTUATED ON/OFF UNLESS SHOWN OTHERWISE.
2. ALL SERVICE VALVES ARE MANUAL UNLESS SHOWN OTHERWISE.
3. ø152 HOLDING TUBE = 18m LONG. FOR 30 SEC. HOLDING TIME.
4. VALVE NOT PHYSICALLY LABELLED.
5. TAGS NOT CHECKED
6. INTERCONNECTION NOT IDENTIFIED. SITE SURVEY REQUIRED.
7. ENCLOSURE ABOVE THE INFEED CONVEYOR
8. ENCLOSURE LOCATED UNDER P5ET4891

HAZARDOUS ZONE 22 EQUIPMENT

REFERENCE DRAWINGS	
	FONTERRA PIPING/MECHANICAL LEGEND SHEETS
	FONTERRA P&ID LEGEND SHEETS
00000556-05	POWDER 5 BIN TIPPER P&ID
	COMPRESSED AIR

2	ISSUED - Mohamed.Chaar@tetrapak.com	SAC	10.06.2024
D	AS BUILT - TETRA PAK	SAC	16.04.2024
1	ISSUED - Henri.Viljoen@tetrapak.com	SAC	21.11.2023
C	FORMAT UPDATE	SAC	29.11.2021
B	FONTERRA STD & CONTINUATIONS	HM	28.04.2017
A	PROJECT ASBUILT PDV-15091010	RB	19.10.2016

REVISIONS

DO NOT SCALE
REPORT ALL ERRORS

AUTOCAD 2023

¥Fonterra_rgb_std_L.PNG

COPYRIGHT:
THIS DRAWING IS THE EXCLUSIVE PROPERTY OF FONTERRA. IT MUST NOT BE COPIED BY ANY MEANS, WITHOUT THE WRITTEN CONSENT OF FONTERRA DRAWING CONTROL.

Drawn	Date
PDV - RB	06.09.2016
Checked	Scale N.T.S

Title.
WHAREROA DPP2
POWDER REWORK
25KG & BULK BAG
P&ID

Dwg No.				Rev
00000556 - 17				2
SITE	PLANT	DISCIPLINE	TYPE	
WH	P5	PI	S	