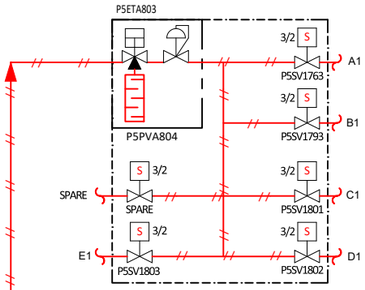

BAG DUMP 25kg (A) CONTROL STATION		
DESCRIPTION	IO TYPE	TAG
START PUSH BUTTON	INPUT	P5PBA741
STOP PUSH BUTTON	INPUT	P5PBA742
CONVEY PUSH BUTTON	INPUT	P5PBA743
START INDICATOR	OUTPUT	P5INA744
STOP INDICATOR	OUTPUT	P5INA745
CONVEY INDICATOR	OUTPUT	P5INA746

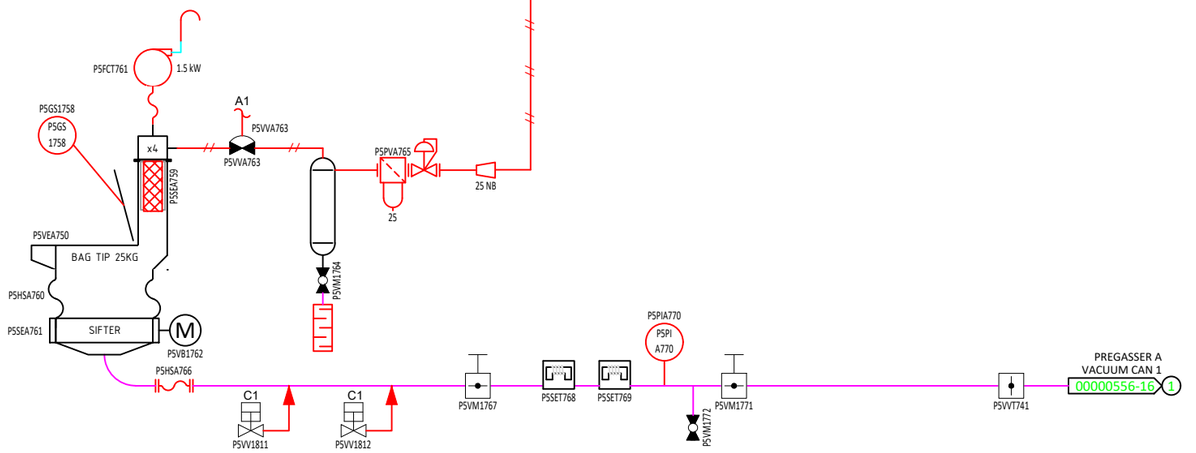

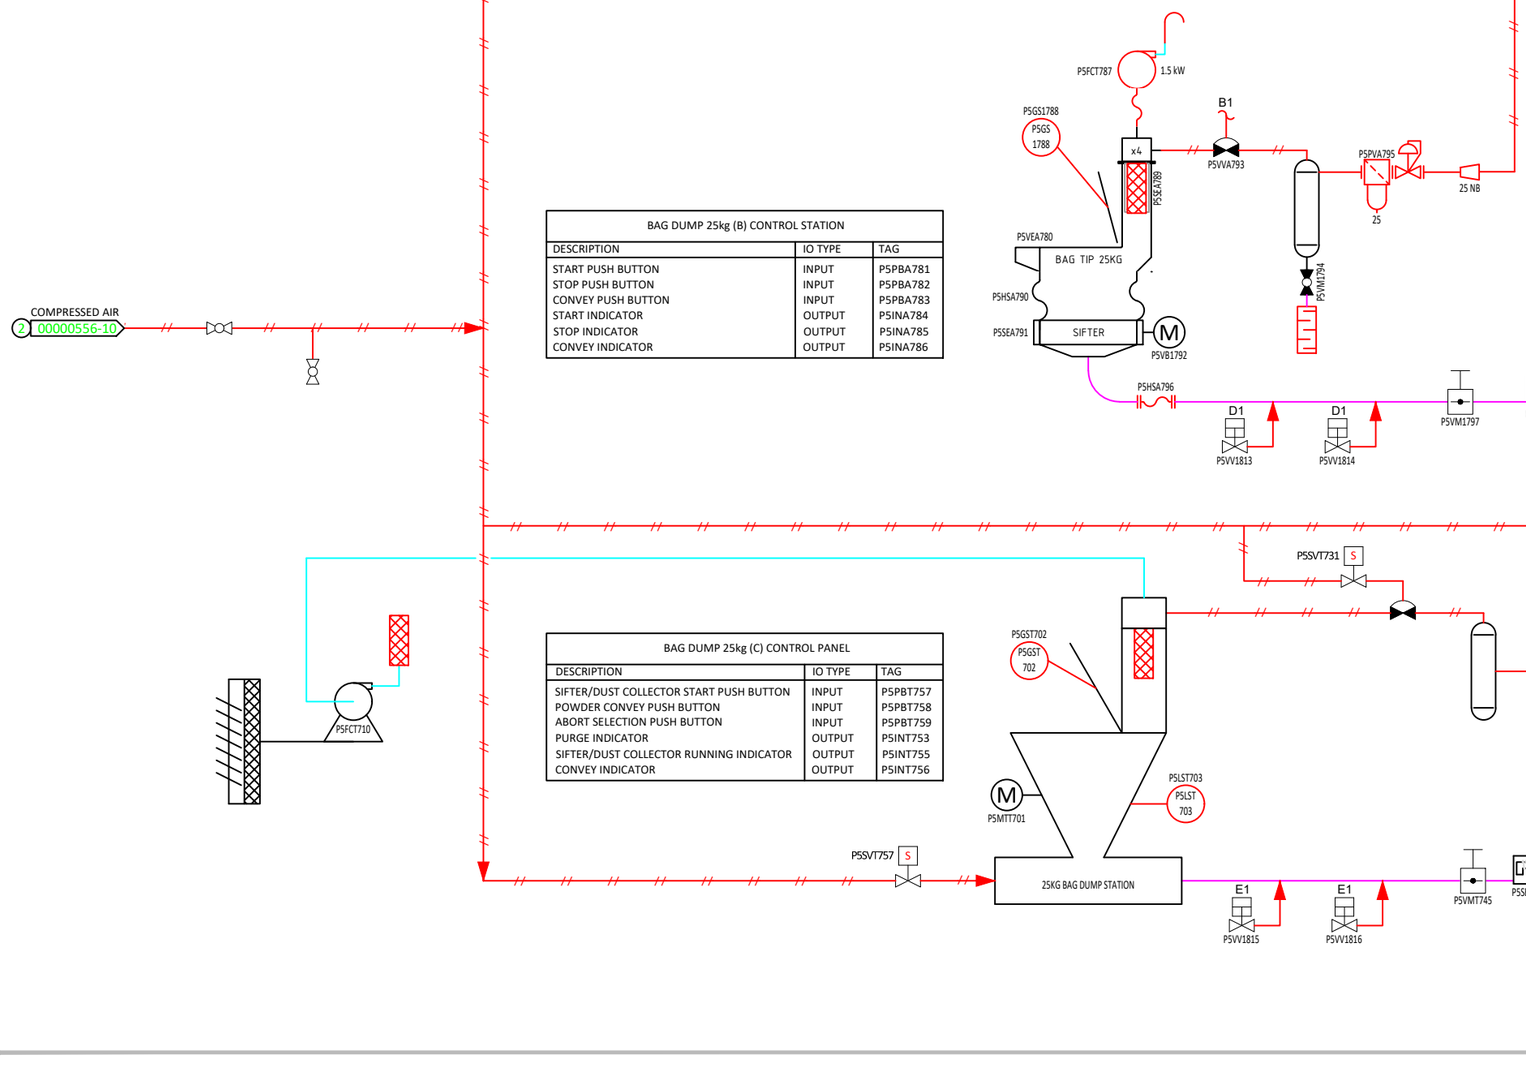

BAG DUMP 25kg (B) CONTROL STATION		
DESCRIPTION	IO TYPE	TAG
START PUSH BUTTON	INPUT	P5PBA781
STOP PUSH BUTTON	INPUT	P5PBA782
CONVEY PUSH BUTTON	INPUT	P5PBA783
START INDICATOR	OUTPUT	P5INA784
STOP INDICATOR	OUTPUT	P5INA785
CONVEY INDICATOR	OUTPUT	P5INA786

BAG DUMP 25kg (C) CONTROL PANEL		
DESCRIPTION	IO TYPE	TAG
SIFTER/DUST COLLECTOR START PUSH BUTTON	INPUT	P5PBT757
POWDER CONVEY PUSH BUTTON	INPUT	P5PBT758
ABORT SELECTION PUSH BUTTON	INPUT	P5PBT759
PURGE INDICATOR	OUTPUT	P5INT753
SIFTER/DUST COLLECTOR RUNNING INDICATOR	OUTPUT	P5INT755
CONVEY INDICATOR	OUTPUT	P5INT756

A1

NOTES:

REFERENCE DRAWINGS	
	FONTERRA PIPING MECHANICAL LEGEND SHEETS
	FONTERRA P&ID LEGEND SHEETS
000556-08	P5 25KG BAG LINE B PREGASSING SYSTEM B
000556-10	P3 25KG BAG LINE C PREGASSING SYSTEM C
000556-16	P4 25KG BAG LINE A PREGASSING SYSTEM A

4	ISSUED - Mohamed.Chaar@tetrapak.com	SAC	10.06.2024
E	AS BUILT - Mohamed.Chaar@tetrapak.com	SAC	16.04.2024
3	ISSUED - Henri.Viljoen@tetrapak.com	SAC	21.11.2023
D	AS BUILT - Mohamed.Chaar@tetrapak.com	SAC	14.11.2023
2	ISSUED - Mohamed.Chaar@tetrapak.com	SAC	23.08.2023
C	PROJECT - AS BUILT	SAC	24.02.2023
B	VALVE TYPE UPDATE - BRENDON FISHER	SAC	19.10.2022
A	ISSUED FOR APPROVAL	SAC	20.09.2021

REVISIONS

DO NOT SCALE
REPORT ALL ERRORS

AUTOCAD 2023

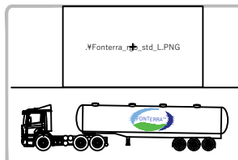

COPYRIGHT:
THIS DRAWING IS THE EXCLUSIVE PROPERTY OF FONTERRA. IT MUST NOT BE COPIED BY ANY MEANS, WITHOUT THE WRITTEN CONSENT OF FONTERRA DRAWING CONTROL.

Drawn: S.A.COOK
Date: 20.09.2021
Checked:
Scale: NTS A1=1:50

Title:
FONTERRA
DPP2 25KG
BAG DUMP
P&ID

Dwg No. 00000556 - 18
Rev. 4

SITE	PLANT	DISCIPLINE	TYPE
WH	P5	PI	S